


TOWNSHIPS 20 & 21 SOUTH, RANGE 22 EAST, W.M.

Gravel Pivot
239⁰ acres

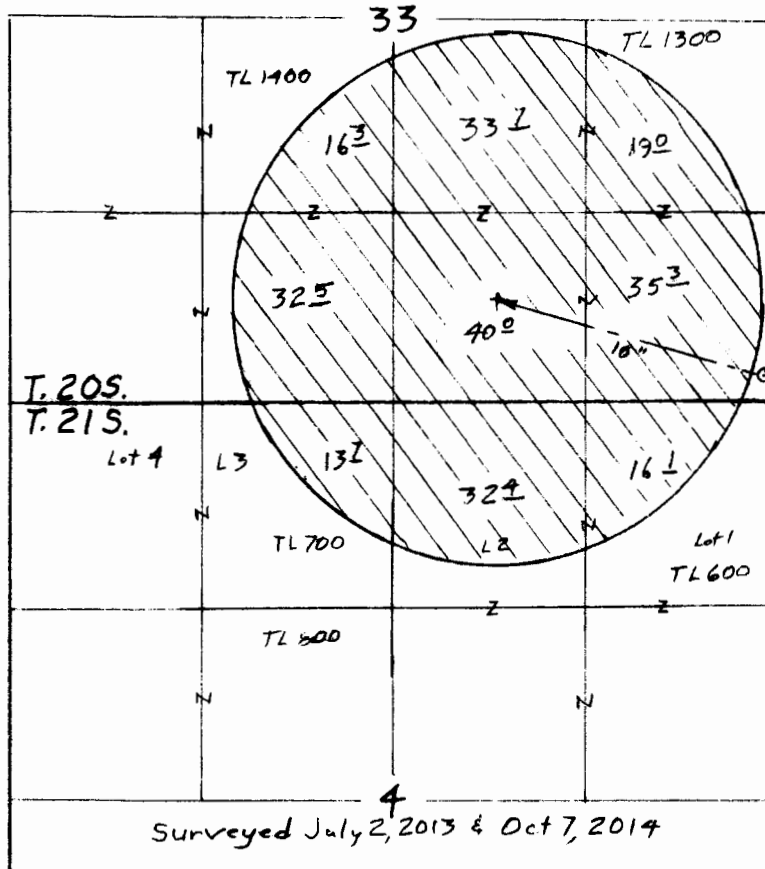


flow meter
Well F-3
160' N &
80' W from
SE Corner

Scale 1" = 1320'
(4" = 1 mile)

⊗ G-17237 239⁰ acres

Claim of Beneficial Use Map
for
GI RANCH


App G-15223
Per G-17237
App G-15657
Per G-17178
PA T-11723

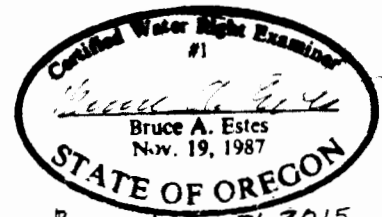

This map is for the purpose of
locating a water right only
and has no intent to provide
legal dimensions or the location
of property lines.

ESTES SURVEYS, LLC
PO Box 17519 60382 Arnold Rd
Salem, OR 97385-7519 Bend, OR 97702
(503) 688-7500 (541) 382-7391

T. 20S, R. 22E, W.M.

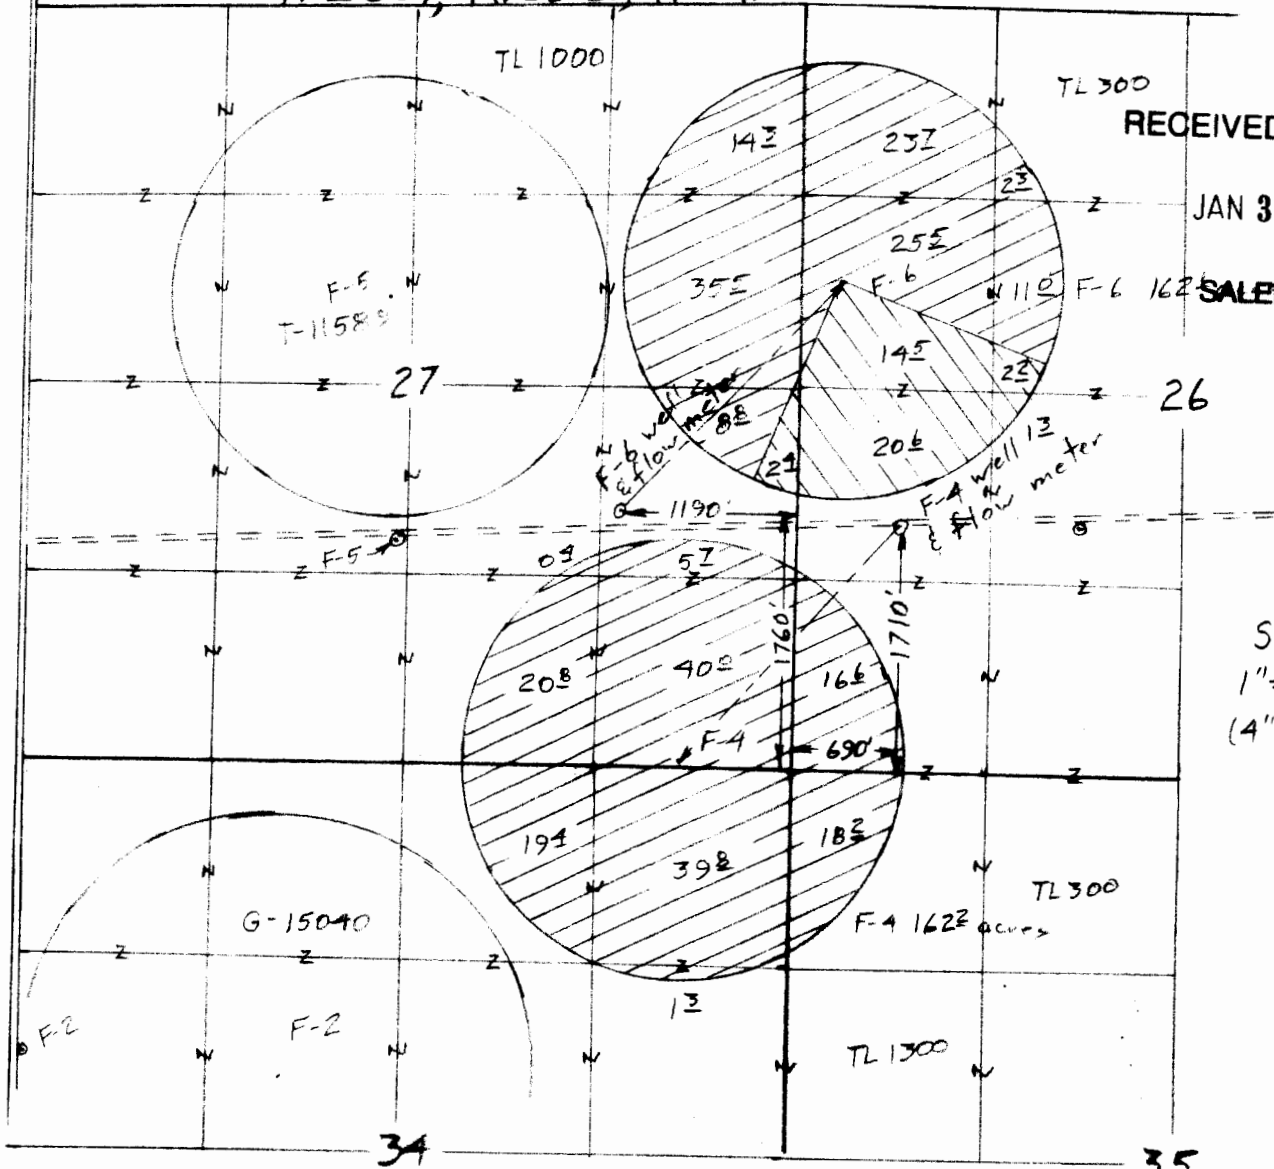

RECEIVED BY OWRD

JAN 30 2015

SALEM, OR

Scale
1" = 1320'
(4" = 1 mile)

Surveyed July 2, 2013 & Oct 7, 2014

- ⊗ F-6 G-17237 419 acres
- ⊗ G-17178 F-4 1623 & F-6 1214 acres

App G-15223
 Per G-17237
 App G-15657
 Per G-17178
 PA T-11723

Claim of Beneficial Use Map
 for
 G I Ranch Corp.



Sheet 2 of 2

This map is for the purpose of locating a water right only and has no intent to provide legal dimensions or the location of property lines.

ESTES SURVEYS, LLC
 PO Box 43846
 Salem, OR 97304-7846
 (503) 325-7800
 80382 Arnold Rd
 Bend, OR 97702
 (541) 323-7301

House Well C-82877

⊗ From 59^o acres

Fife C-90460



⊗ From 91^o acres

F-3 C-90461

⊗ From 11^o acres

○ Remain 228^o

Scale
1" = 1320'
(4" = 1 mile)

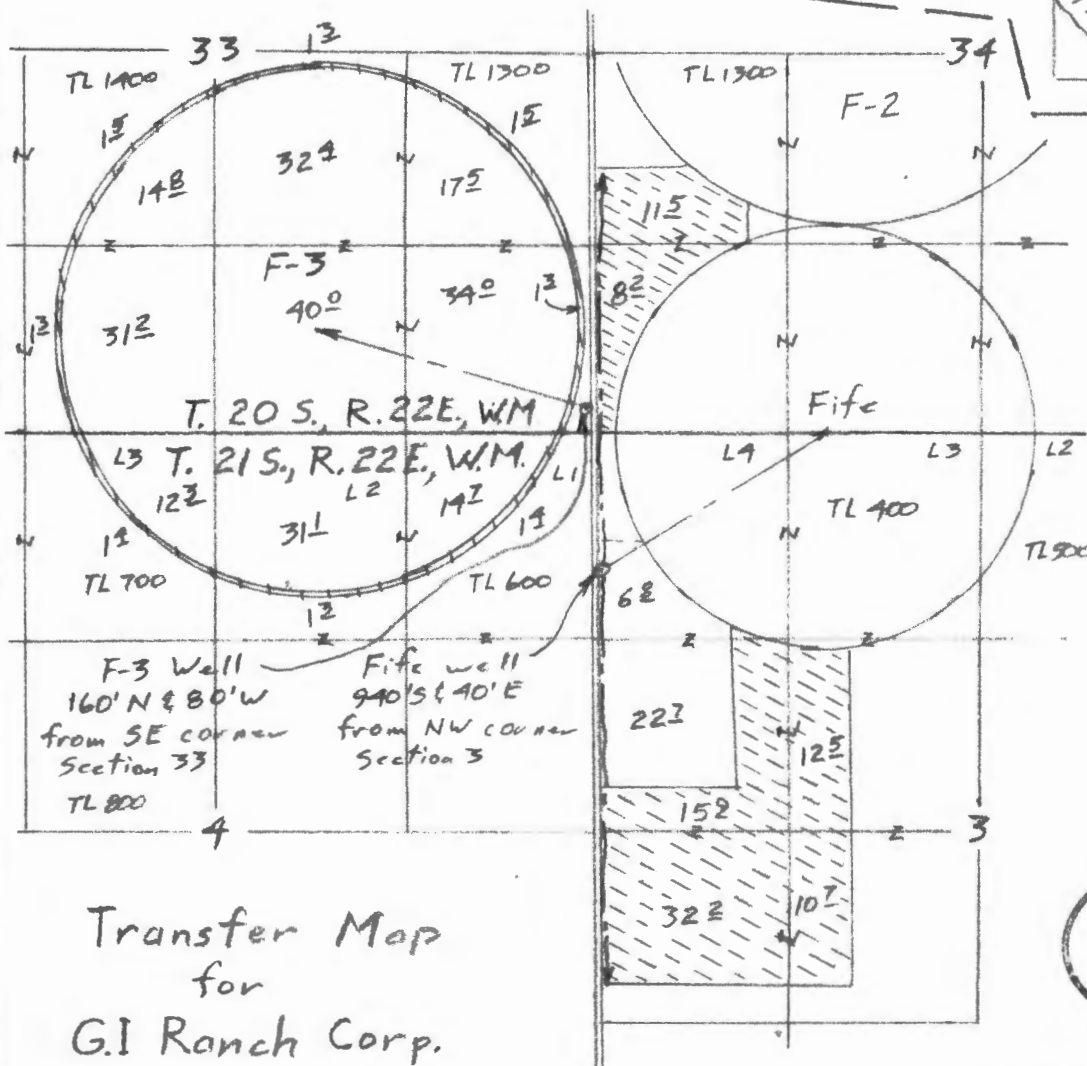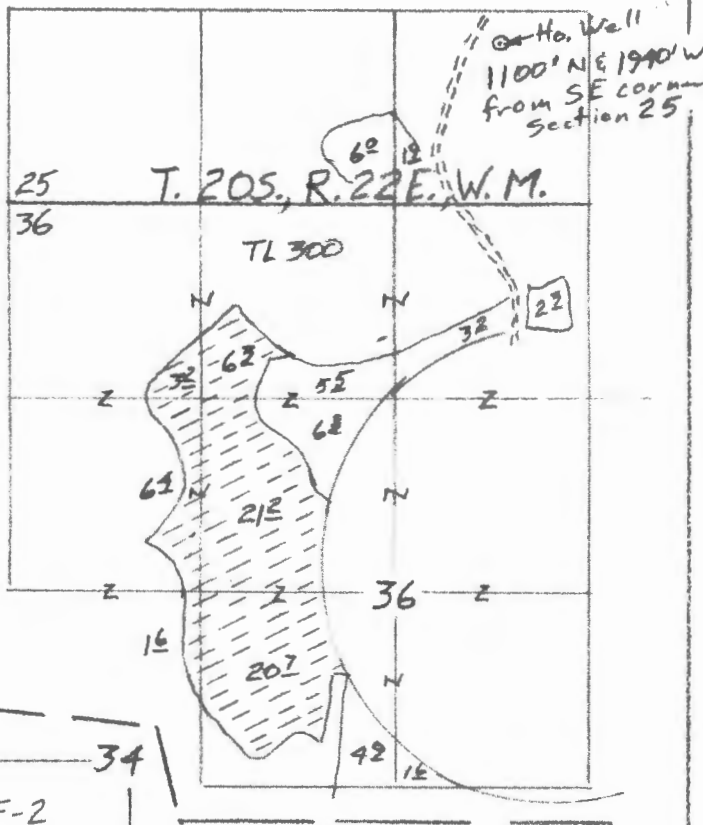

F-3 Well
160' N & 80' W
from SE corner
Section 33
TL 800


Fife well
940' S & 40' E
from NW corner
Section 3

Transfer Map
for
G.I Ranch Corp.

RECEIVED BY OWRD

MAR 10 2016

SALEM, OR

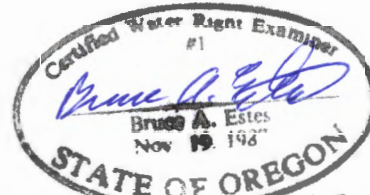

Renewal Dec 31, 2015
Sheet 3 of 4

ESTES SURVEYS

PO Box 17519
Salem, OR 97385-7519
(503) 586-7605

60382 Arnold Rd
Bend, OR 97702
(541) 382-7391

This map is for the purpose of
locating a water right only
and has no intent to provide
legal dimensions or the location
of property lines.