


CLAIM OF BENEFICIAL USE MAP FOR PERMIT G-15559


T 35 S, R 6 W, WM, JOSEPHINE COUNTY

Section 2, SE1/4 SE1/4

October 8, 2009

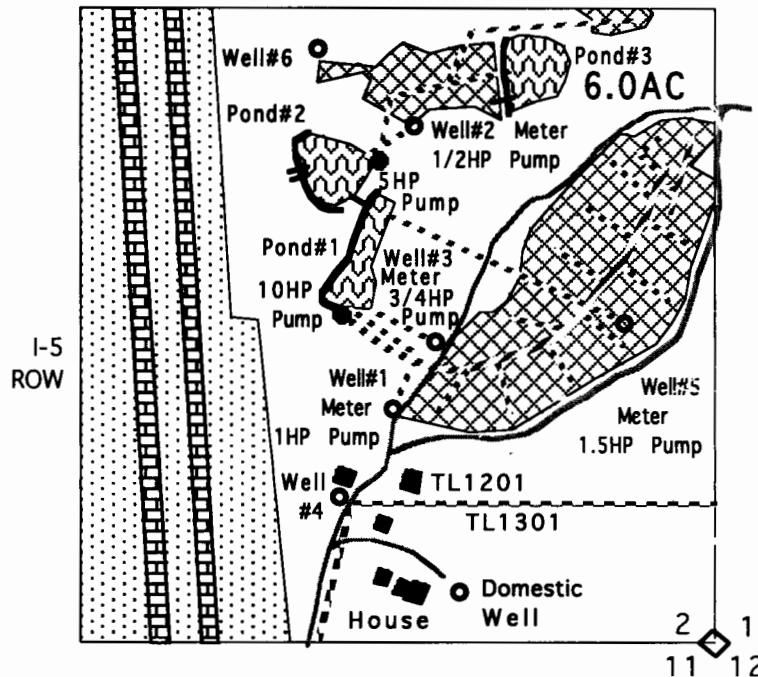

N
1"=400'

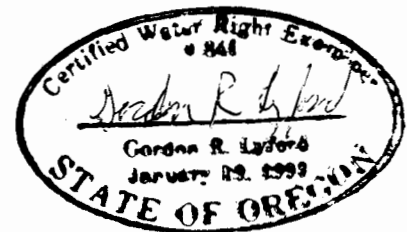

10-8-2009
exp 12-31-2010

6.0 acres of primary irrigation developed under Application G-15911 and Permit G-15559 with a priority of January 17, 2003, and a rate of 1/80 cfs and a duty of 2.5 AF per acre.

Four Authorized Points of Appropriation:

Well#1, JOSE#12081 & JOSE#54833, 260 feet deep.

Located 490 feet North and 670 feet West from the Southeast corner of Section 2.

Well#2, JOSE#12080, 100 feet deep.

Located 1080 feet North and 630 feet West from the Southeast corner of Section 2.

Well#3, JOSE#12078, 120 feet deep.

Located 630 feet North and 580 feet West from the Southeast corner of Section 2.

Well#5, JOSE#13306, 120 feet deep.

Located 670 feet North and 190 feet West from the Southeast corner of Section 2.

Ponds #1, #2, and #3.

Dams & 15" culvert spills.

Gravel roads.

Buried PVC pipelines.

Buildings.

Tax lot lines.

Other Wells:

Well#4, JOSE#13090, 100 feet deep.

Located 310 feet North and 780 feet West from the Southeast corner of Section 2.

Well#6, JOSE#53477, 225 feet deep.

Located 1240 feet North and 830 feet West from the Southeast corner of Section 2.

Domestic Well for House, JOSE#19348, 200 feet deep.

Located 110 feet North and 530 feet West from the Southeast corner of Section 2.

This map was drawn by Gordon R. Lyford for Brad H. and Kris L. Vandehey to support their Claim of Beneficial Use under Permit G-15559 for the irrigation of a golf course.

They own tax lots 1201 and 1301.

This map was prepared for the purposes of identifying the location of water rights only and is not intended to provide legal dimensions or the location of property ownership lines.