

RECEIVED

JUN 23 1999

WATER RESOURCES DEPT.
SALEM, OREGON

REVISION

ANDERSON ENGINEERING
AND SURVEYING, INC.
P.O. BOX 28
LAKEVIEW OREGON 97630
P.O. BOX 419
REDFORD OREGON 97755

PREPARED FOR:
RICHARD MENSCH
PO BOX 628


DATE: 6/07/99
SCALE: 1"=1320'
JOB: 98048
DWG. BY: M.J.E
FILE: 98048
SHEET 1 OF 1

FINAL PROOF SURVEY

FOR TRANSFER 7204
LOCATION OF NEW POINT OF APPROPRIATION
AND PLACE OF USE
LOCATED IN SECTION 36
TOWNSHIP 25 SOUTH, RANGE 18 EAST, W.M.
LAKE COUNTY, OREGON


RANGE 18 EAST x RANGE 19 EAST

SCALE: 1"=1320'

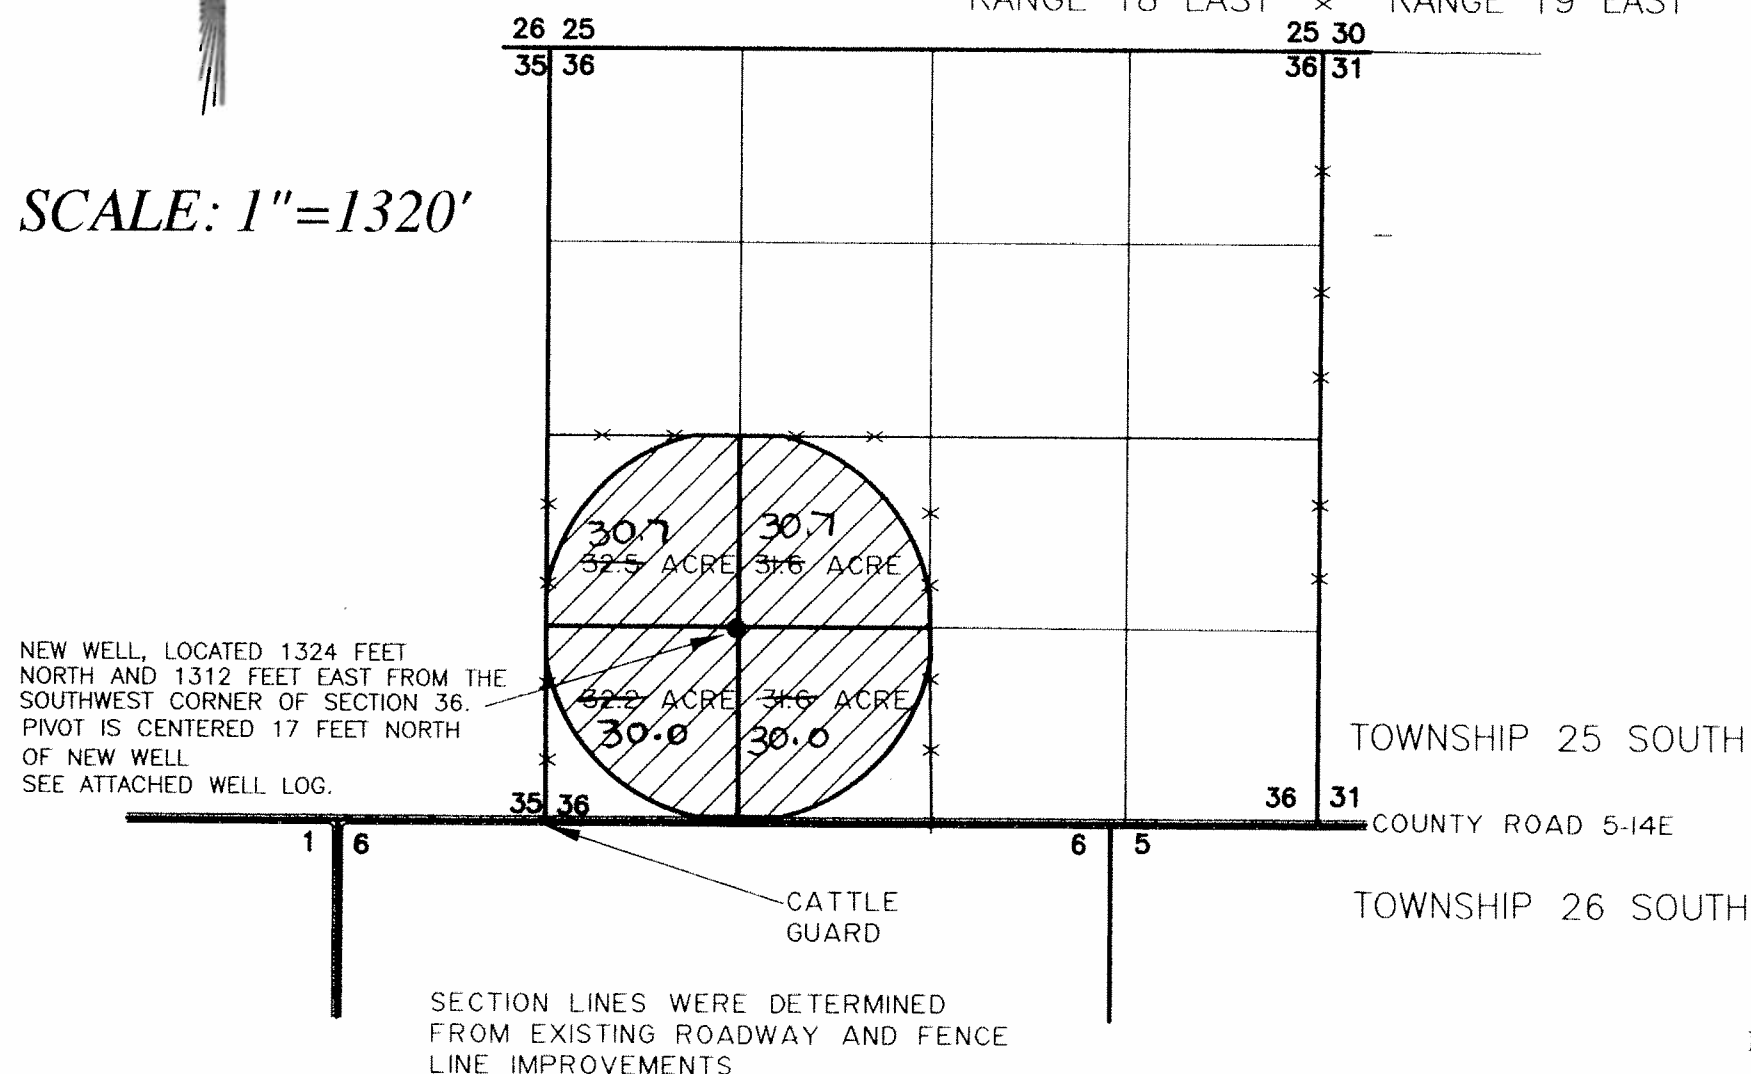

LEGEND

- SECTION LINE
- 1/4 SECTION LINE
- 1/16 SECTION LINE
- EXISTING WELL
- EXISTING BARB WIRE FENCE

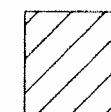


121.4
~~127.9~~ ACRES BEING IRRIGATED FROM
NEW WELL AS SHOWN

TOTAL ACRES IRRIGATED UNDER NEW WELL AS PER T-7204= 127.9 ACRES
TOTAL ACRES ALLOWED UNDER T-7204= 121.4 ACRES

NOTE: PREPARATION OF THIS MAP IS FOR IDENTIFYING PROPOSED WATER RIGHTS ONLY. IT HAS NO INTENT TO PROVIDE LOCATIONS OR DIMENSIONS OF PROPERTY BOUNDARIES.

This map has been revised by WRD to reflect the correct amount of acreage authorized by the transfer final order. Jls 3-22-16

SEE ACCOMPANYING
SITE REPORT

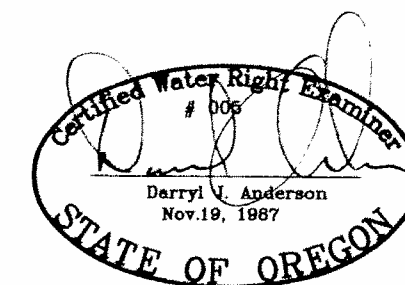

RENEWAL 12/31/99