


FINAL PROOF MAP T-8979  
 NW1/4NW1/4 SECTION 13, T.39S., R.3W., W.M.  
 JACKSON COUNTY, OREGON  
 FOR  
 GAIL L. APILADA  
 1999 LITTLE APPLGATE ROAD  
 JACKSONVILLE, OREGON 97530

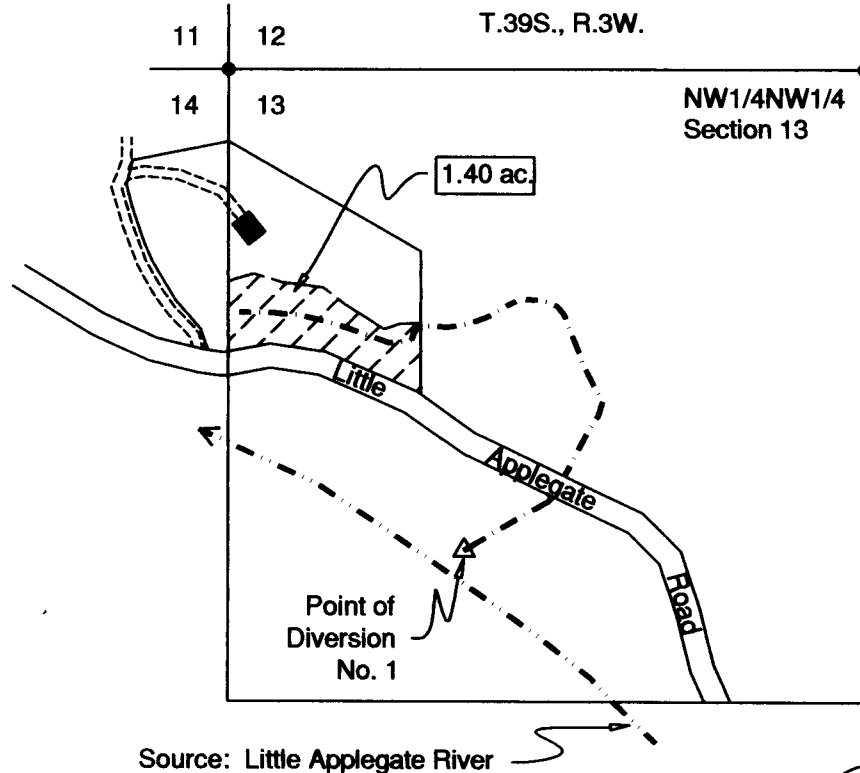

**RECEIVED**  
 OCT 11 2005  
 WATER RESOURCES DEPT  
 SALEM, OREGON

Source: Little Applegate River



**LEGEND**

- Found Survey Monument
- Denotes Building
- Denotes Driveway
- - - - - Denotes Mainline Pipe
- ▨ Denotes Area Under Special Order Volume 56 Pages 2251-2255

Scale: 1"=400'

Date: September 23, 2005

Point of Diversion No. 1 -  
 1005 ft. South and 491 ft.  
 East from NW Corner,  
 Section 13.



HAROLD L. CENTER  
 2604 David Lane  
 Medford, OR. 97504  
 Phone 541-535-6108  
 Oregon Certificate No. 152  
 Certificate Renewal Date: 12/31/2005

This map was prepared for the purpose of identifying the location of a water right only and is not intended to provide legal dimensions or location of property ownership.