


MAP TO ACCOMPANY CLAIM OF BENEFICIAL USE FOR  
FOR CHANGE IN POINT OF DIVERSION AND PLACE OF USE

*Alfred and Ginger Zuppan*

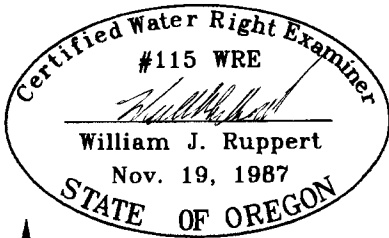


TRANSFER T-8493

MAP PREPARED BY:  
WILLIAM J. RUPPERT  
P.O. BOX 1564  
MYRTLE CREEK, OR 97457  
AUGUST, 2001

SCALE 1"=1320'

T29S R3W WM

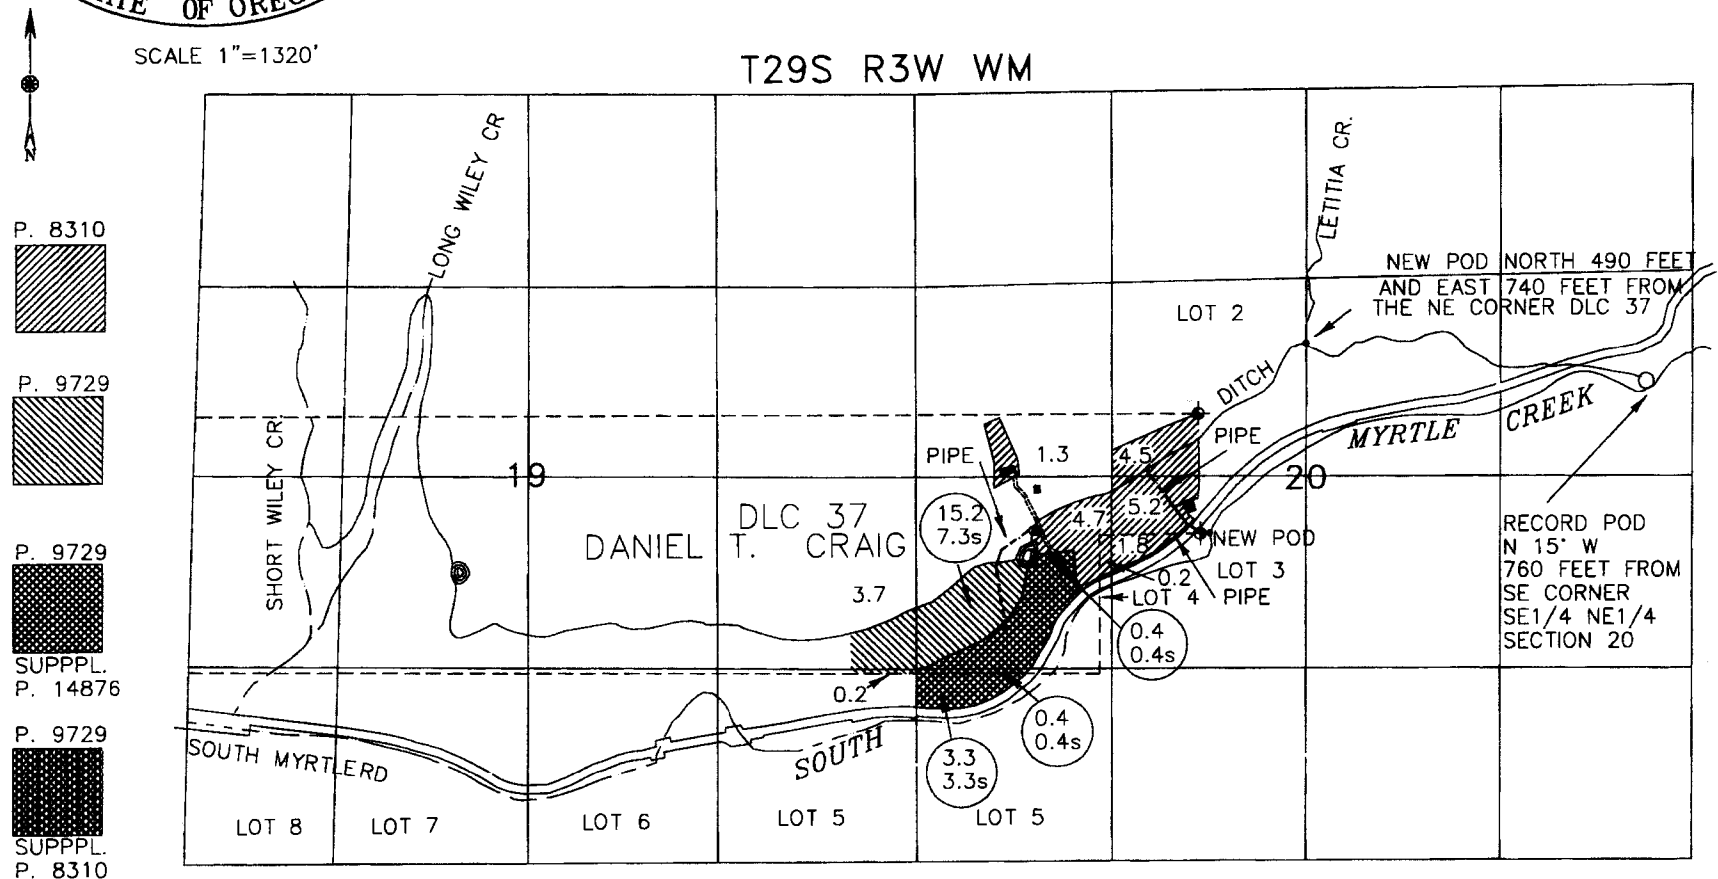


THIS MAP TO BE USED FOR WATER RIGHT PURPOSES ONLY

*Dean*