


MAP TO ACCOMPANY CLAIM OF BENEFICIAL USE FOR
FOR CHANGE IN POINT OF DIVERSION AND PLACE OF USE

Alfred and Ginger Zuppan

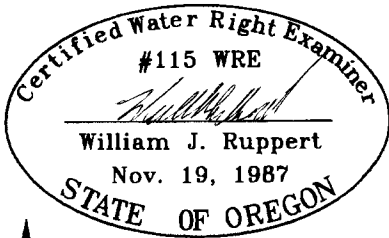


TRANSFER T-8493

MAP PREPARED BY:
WILLIAM J. RUPPERT
P.O. BOX 1564
MYRTLE CREEK, OR 97457
AUGUST, 2001

SCALE 1"=1320'

T29S R3W WM

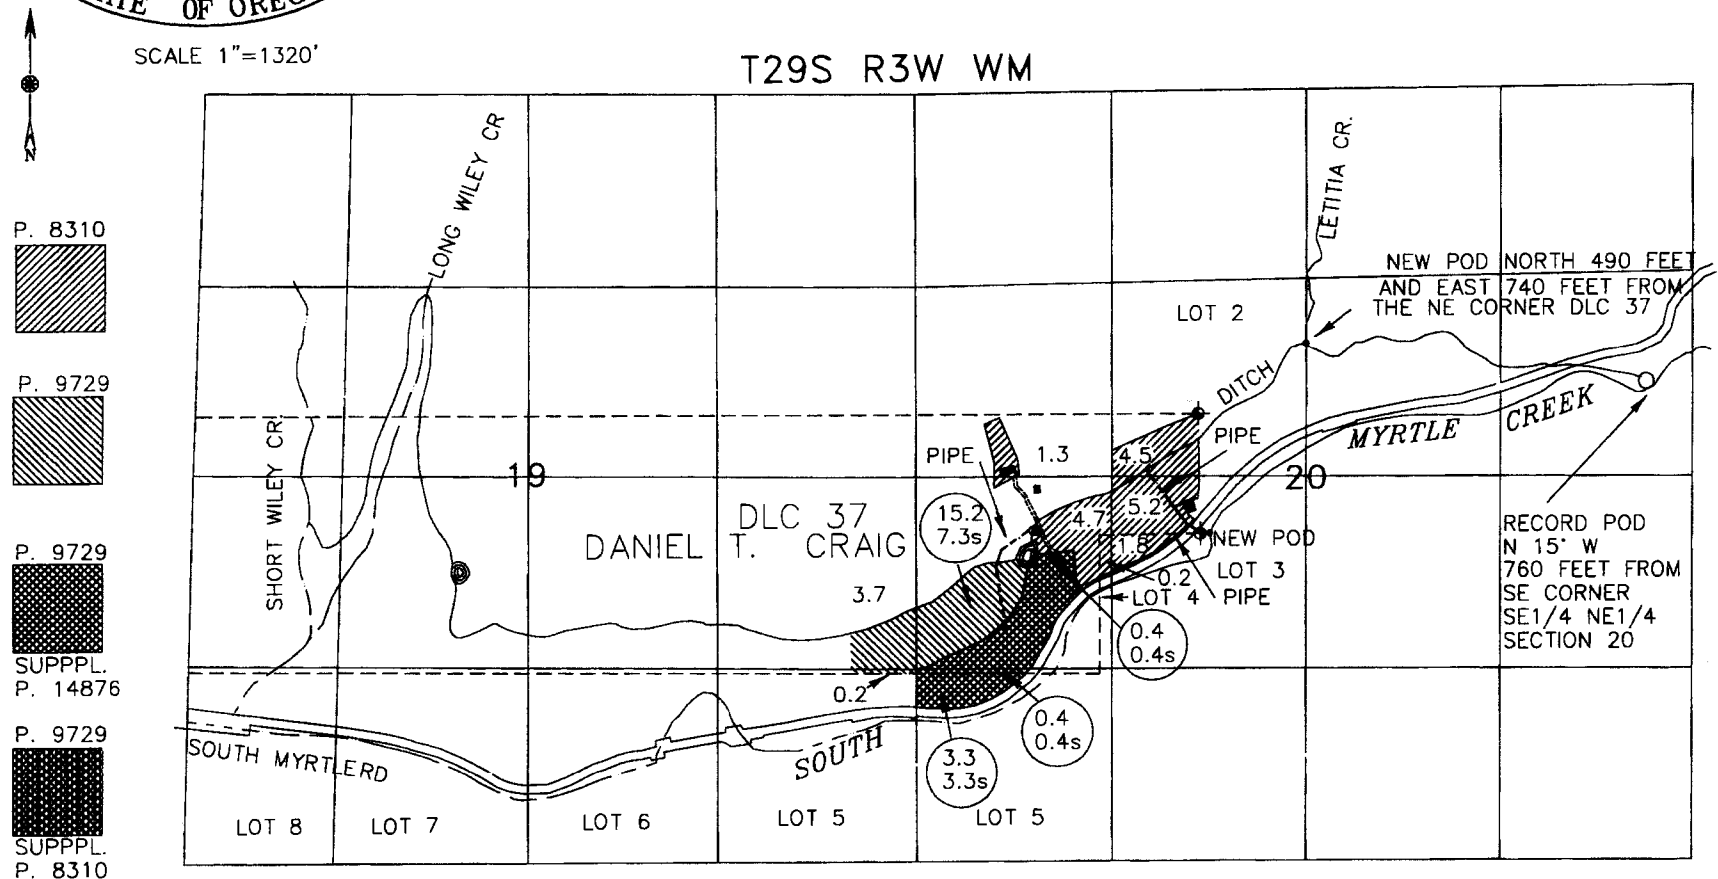

P. 8310

P. 9729

P. 9729

SUPPL. P. 14876

P. 9729


SUPPL. P. 8310

NEW POD NORTH 10 FEET AND EAST 65 FEET FROM ESE CORNER DLC 37, T29S R3W, WM

THIS MAP TO BE USED FOR WATER RIGHT PURPOSES ONLY

Dean

MAP TO ACCOMPANY CLAIM OF BENEFICIAL USE FOR CHANGE
IN POINT OF DIVERSION AND PLACE OF USE.

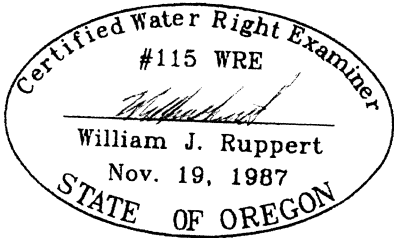


TRANSFER T-8493

for Richard M. and Emma P. Deam

MAP PREPARED BY:
WILLIAM J. RUPPERT
P.O. BOX 1564
MYRTLE CREEK, OR 97457
AUGUST 2001

SCALE 1"=1320'

T29S R3W WM

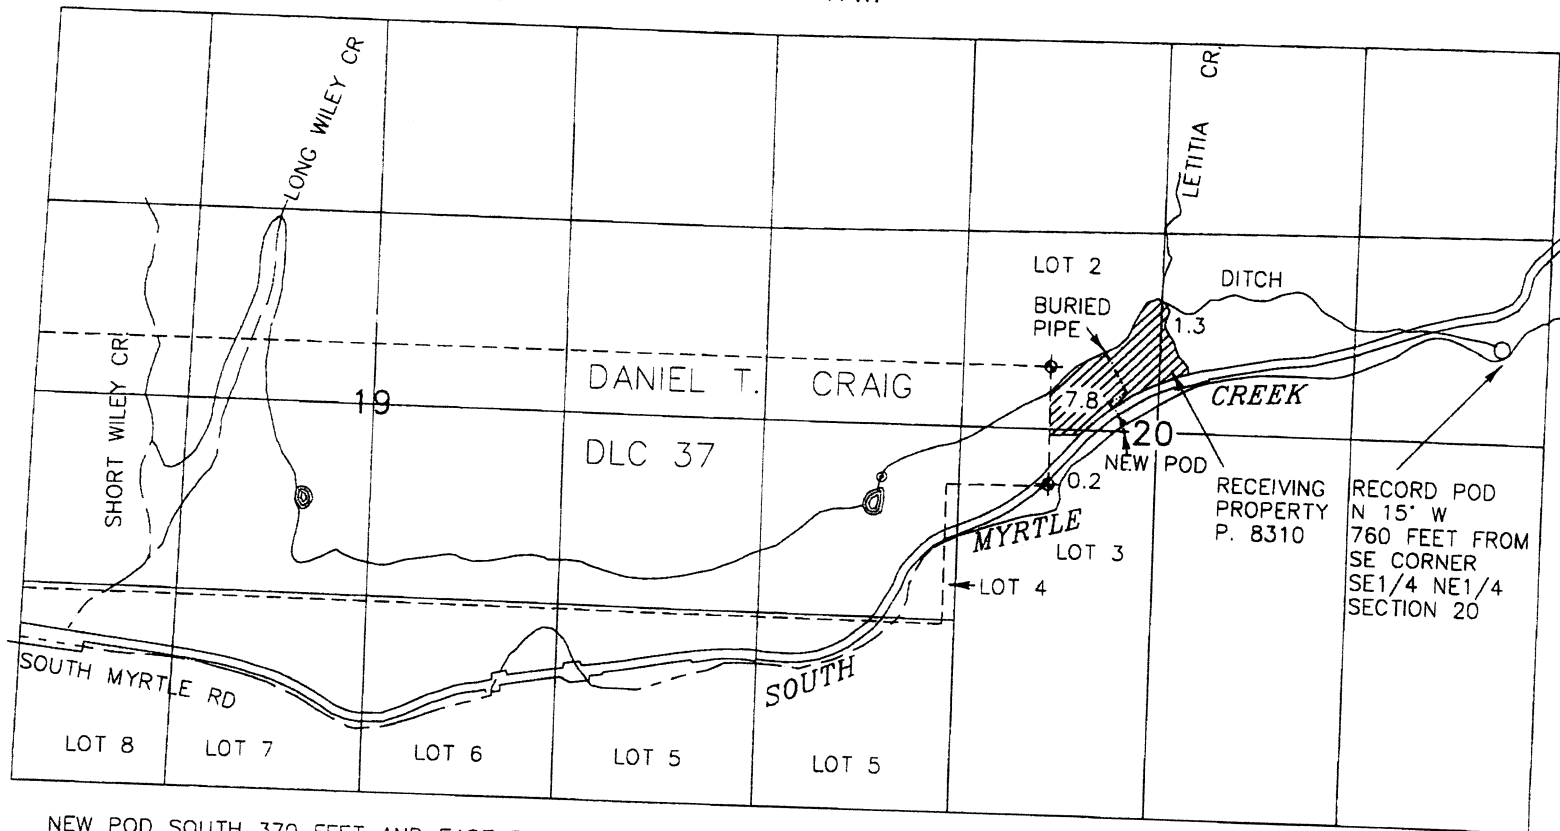

NEW POD SOUTH 370 FEET AND EAST 500 FEET FROM NE CORNER DLC 37, T29S R3W, WM

THIS MAP TO BE USED FOR WATER RIGHT PURPOSES ONLY