


T. 38S., R. 4W., W. M.

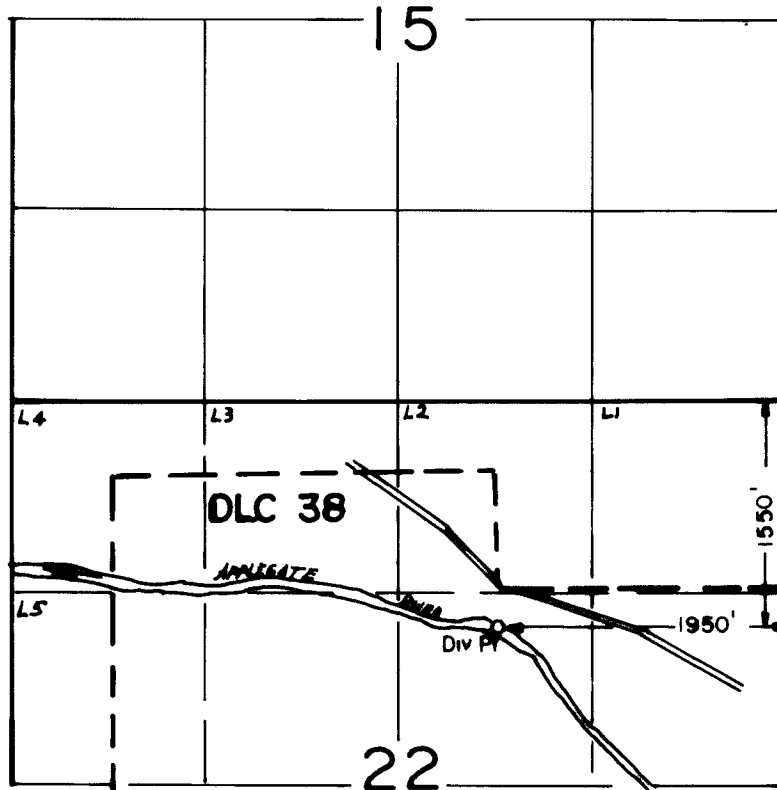

SCALE: 1" = 1320'

FINAL PROOF SURVEY
UNDER

TRANSFER NO. 5793


Application No. Permit No.
IN NAME OF

.....**HERRIOTT BROTHERS RANCH**.....

Surveyed NOV..22.. 1989., by B.S. JAMES.....

T. 38 S., R. 4 W., W.M.

T-5793

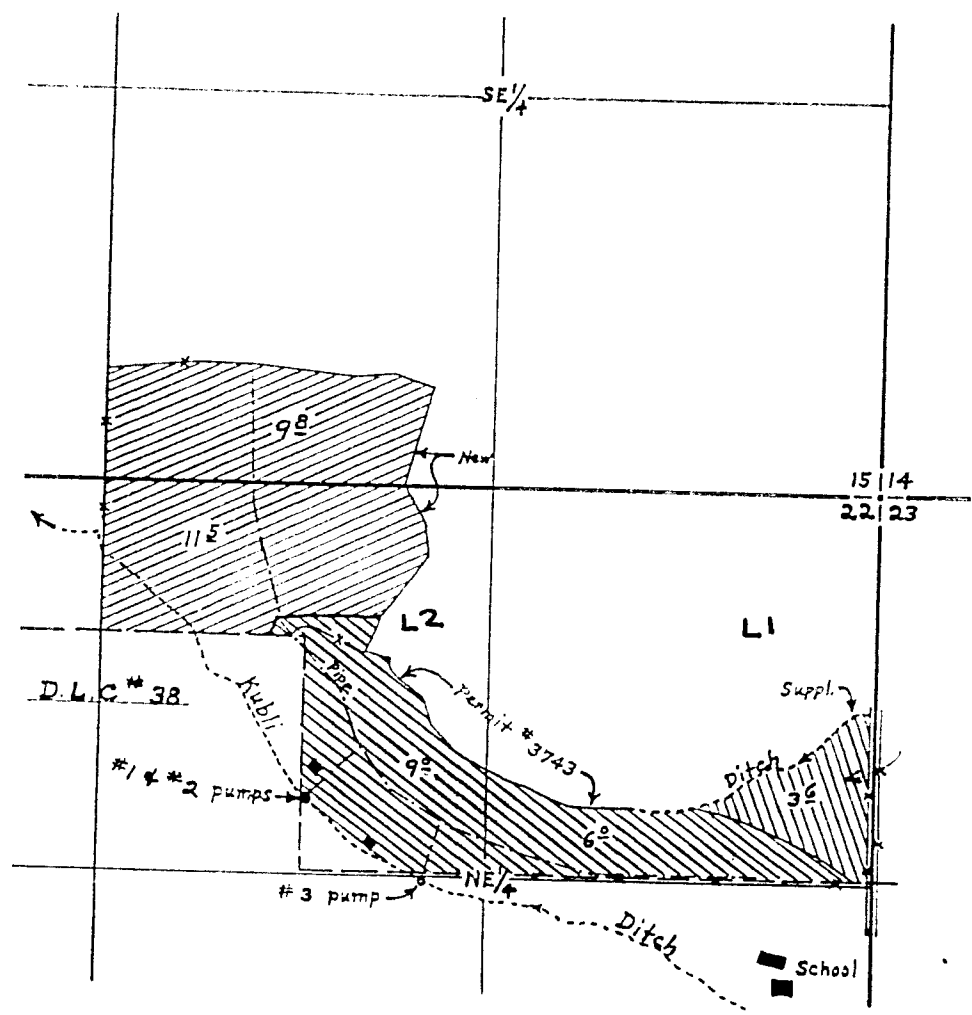

Use to Show
POU

FINAL PROOF SURVEY UNDER

Application No. 28625, Permit No. 6552a
IN NAME OF

Karl E. Henriott

Surveyed Jan 25 1961 by Paul Henderson