


T. 38S., R. 4W., W. M.

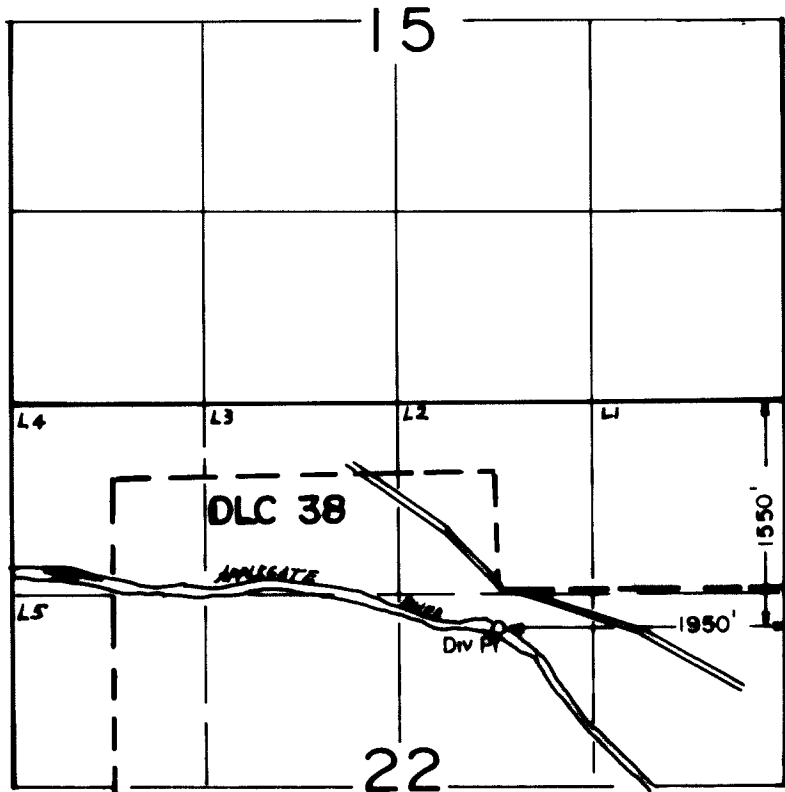

SCALE: 1" = 1320'

FINAL PROOF SURVEY
UNDER

TRANSFER NO. 5793


Application No. Permit No.
IN NAME OF

.....**HERRIOTT BROTHERS RANCH**.....

Surveyed NOV..22.. 1989., by B.S. JAMES.....

T. 38 S., R. 4 W., W.M.

7-5-193

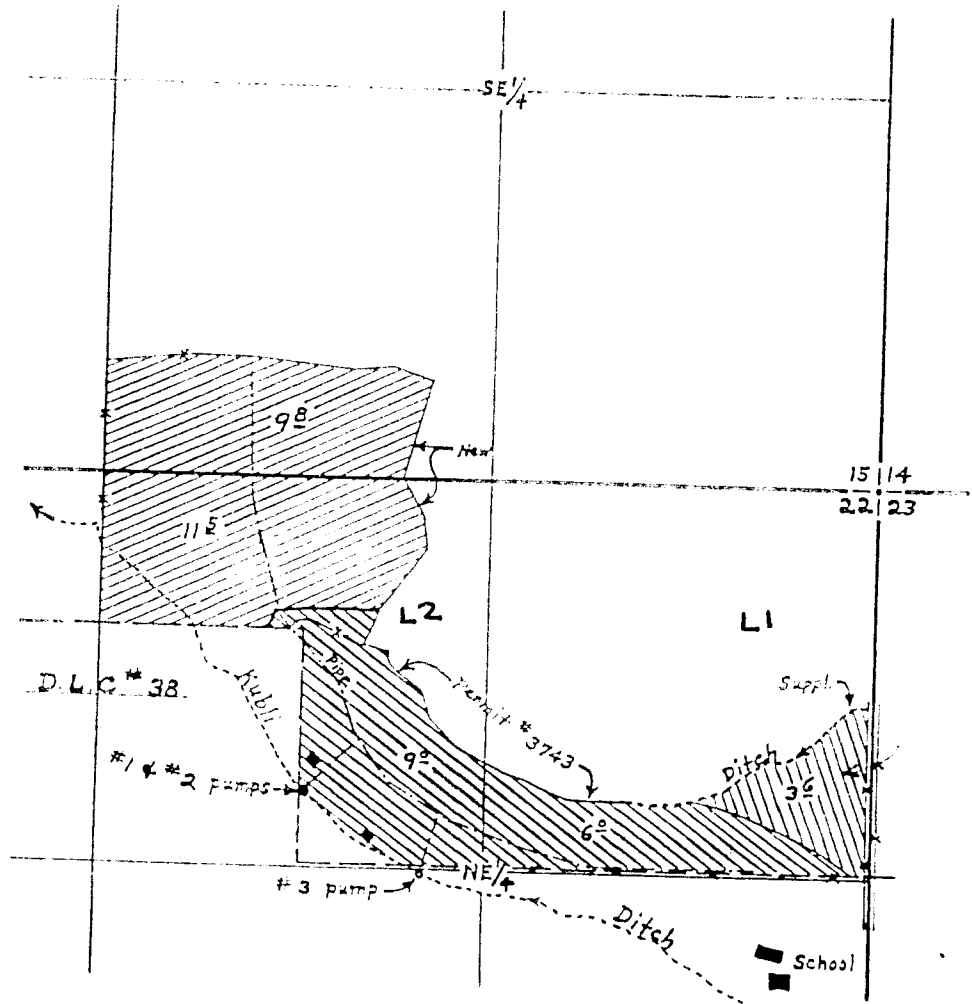

Use to Show
POU

FINAL PROOF SURVEY

UNDER

APPROVED FOR FILE 1931
COMMISSIONER OF

LAND & MINERAL

DATE 5-5-1931 BY E. J. [unclear]