


T. 13S., R. 1E., W.M.

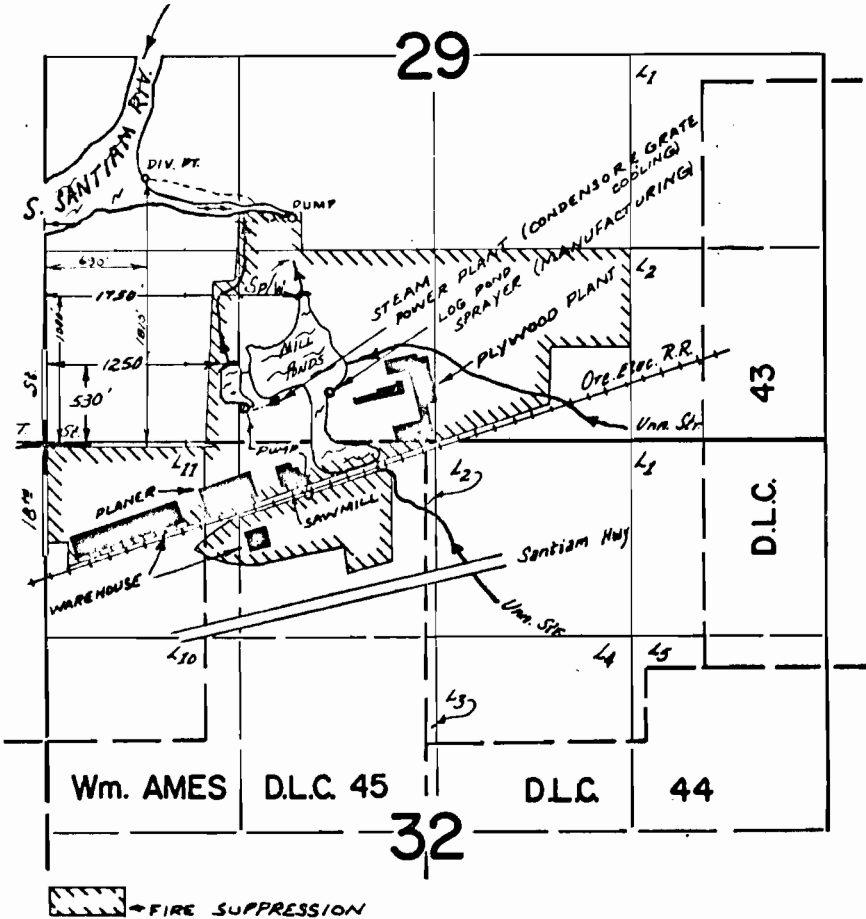

FINAL PROOF SURVEY UNDER

R-46151

R-5488

Application No. 46152 Permit No. 34480

IN NAME OF

WILLAMETTE INDUSTRIES, INC.

Surveyed 19 Sept. 1972, by D. Norby
MAY 8 1973 R. MUCKEN
AUG 9 1974 D. NORBY
OCT 14 1974 D. NORBY