


# CLAIM OF BENEFICIAL USE MAP T-11176

SECTION 36, T1S, R3W, WM  
 TL 900, 902, 1800 (TAX MAP 1S3-36)  
 WASHINGTON COUNTY, OREGON  
 WILLAMETTE RIVER BASIN

PREPARED FOR:  
 TWIGG FARMS  
 31500 SW FIRDALE ROAD  
 CORNELIUS, OR 97113

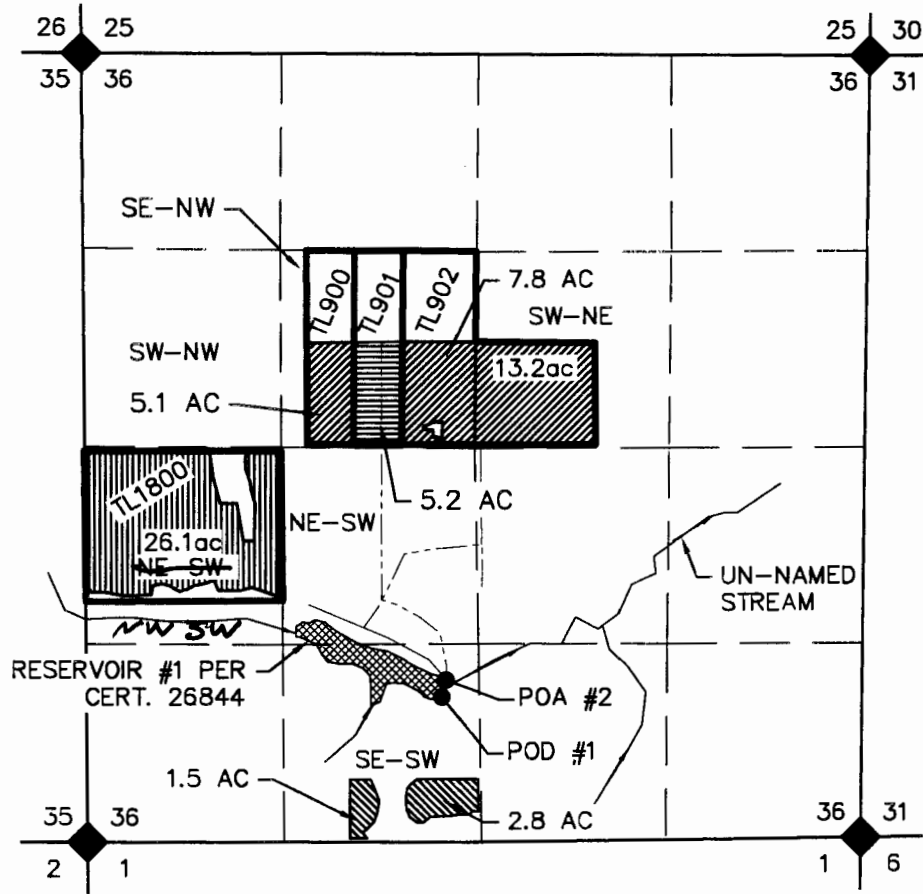


All of the land between the diversions and the POU is owned by Twigg Farm and that is why the pipelines are not shown.

- FROM LANDS CERT. 68504 AND 76062
- CERT 68504 LANDS UNCHANGED
- TO LANDS CERT. 68504 AND 76062
- CERT 76062 LANDS UNCHANGED.

POD #1 (DAM) IS 1000' NORTH AND 240' WEST OF SOUTH 1/4.  
 POA #2 (WELL) IS 1100' NORTH AND 190' WEST OF SOUTH 1/4.

- POD OR POA
- SECTION CORNER
- TAXLOT BOUNDARY
- 16TH LINE
- SECTION LINE
- PIPELINE

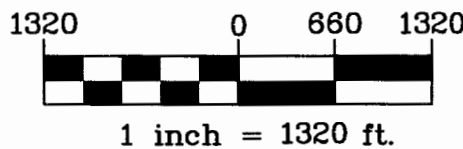

MAP BASE:  
 WASH COUNTY TAX MAP 1S336, 2010 GOOGLE AERIAL PHOTO, AND CERT MAPS  
 THIS MAP WAS PREPARED FOR THE PURPOSE OF IDENTIFYING THE  
 LOCATION OF A WATER RIGHT ONLY AND IS NOT INTENDED TO PROVIDE  
 LEGAL DIMENSIONS OR LOCATION OF PROPERTY OWNERSHIP LINES.

Project: 310-2-080  
 Drawing: 3102080\_COBU.dwg  
 By: DYLAN HITNER  
 Checked by: ERIC URSTADT  
 Date: JAN 21, 2014

WRD revised map to NWSW, sec. 36. mfb/wrd 6-28-16