


541.382.4707 • wallacegroup-inc.com


PROJECT PECK PROPERTY PROJECT NO.
SUBJECT FINAL PROOF SURVEY BY RSW DATE 11-11-15
SMALL RESERVOIR REVIEWED BY DATE

TOWNSHIP 5 SOUTH, RANGE 27 EAST, W.M.
SE $\frac{1}{4}$ OF NW $\frac{1}{4}$, SEC. 17

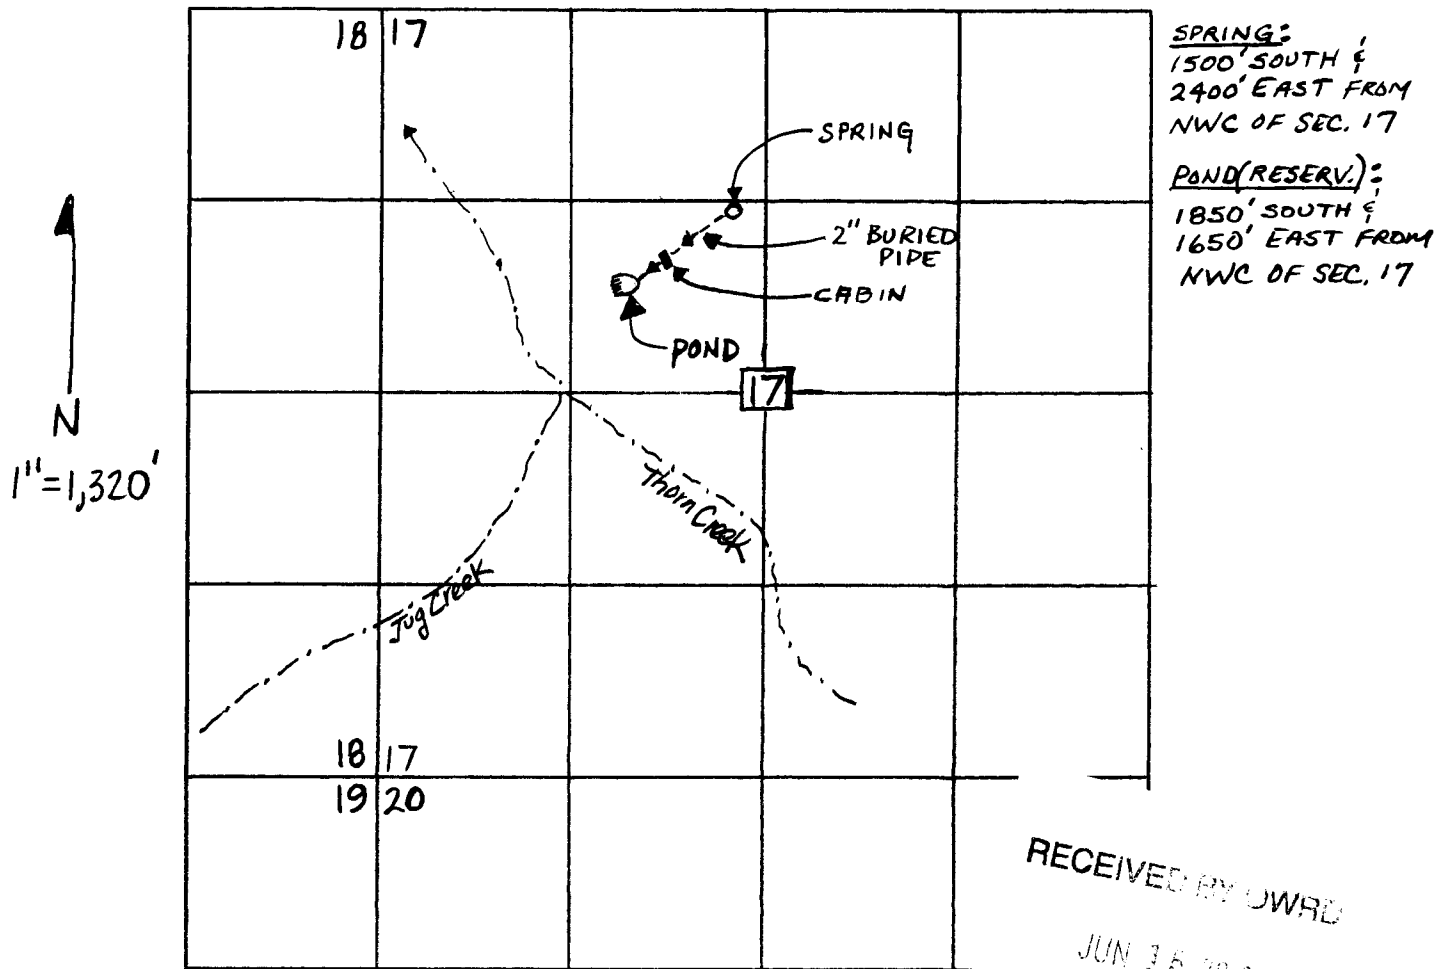

FINAL PROOF SURVEY
under
APPL. NO. R-57727; PERMIT NO. R-7690

RECEIVED BY OWRD
JUN 16 2016
SALEM, OR

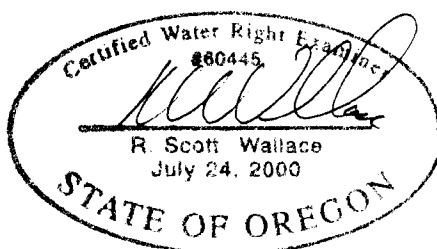

EXPIRATION DATE: 06/30/2016

THIS MAP WAS PREPARED FOR THE
PURPOSE OF IDENTIFYING THE LOCATION
OF A WATER RIGHT ONLY AND IS NOT
INTENDED TO PROVIDE LEGAL
DIMENSIONS OR LOCATION OF PROPERTY
OWNERSHIP LINES.