

RECEIVED BY OWRD

JUL 01 2015

SALEM, OR


T5S R23E TL 2400

3 ponds Reservoir Permit R-13288

No Name Reservoir Permit R-13289

Lost Valley Rd. Pond #2 Permit R-14657

1 inch = 1,320 feet

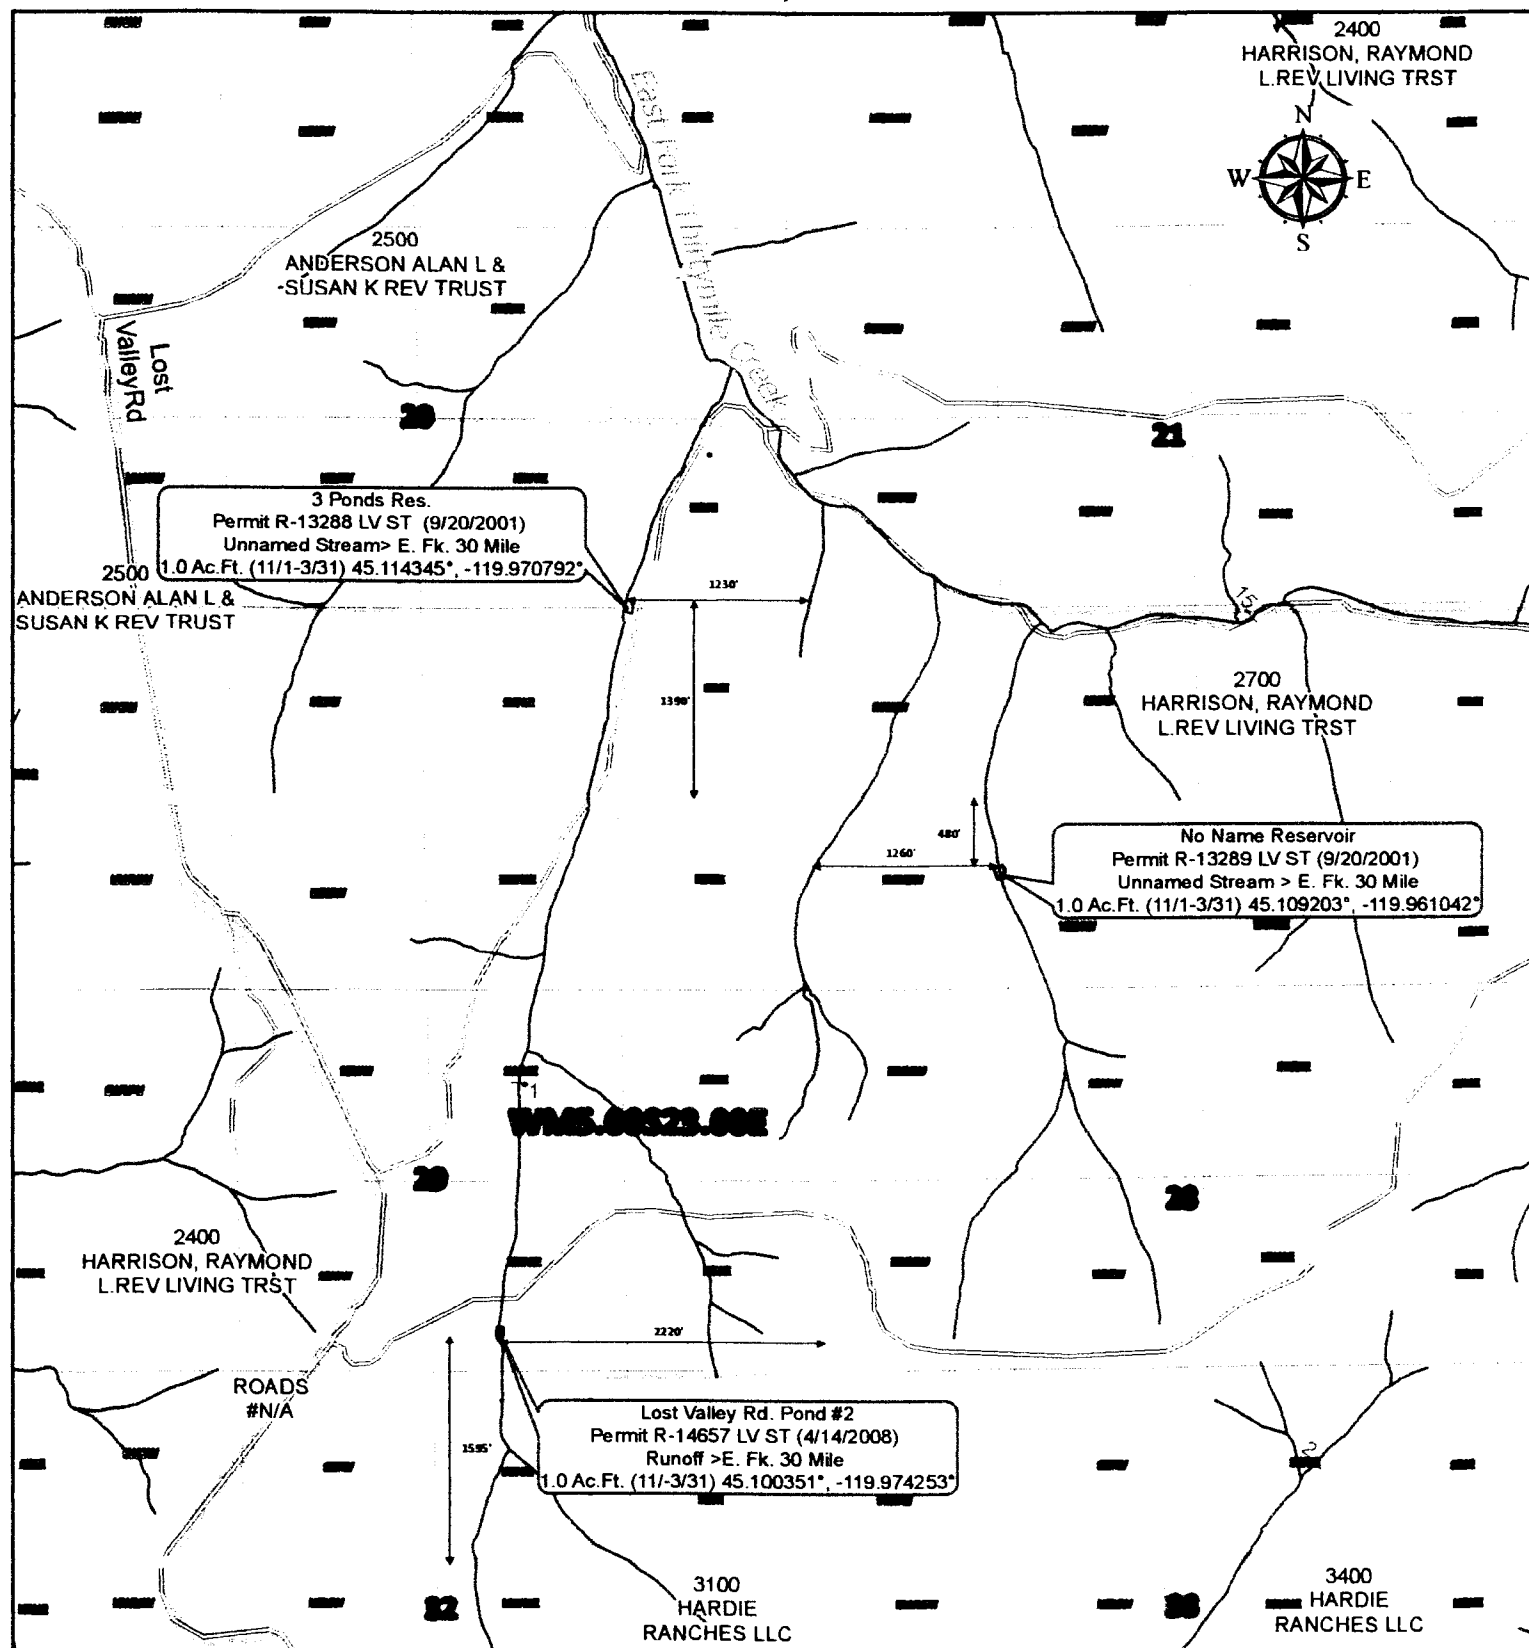

RECEIVED BY OWRD

JUL 01 2015

SALEM, OR


T5S R23E TL 2400

3 ponds Reservoir Permit R-13288

No Name Reservoir Permit R-13289

Lost Valley Rd. Pond #2 Permit R-14657

1 inch = 1,320 feet

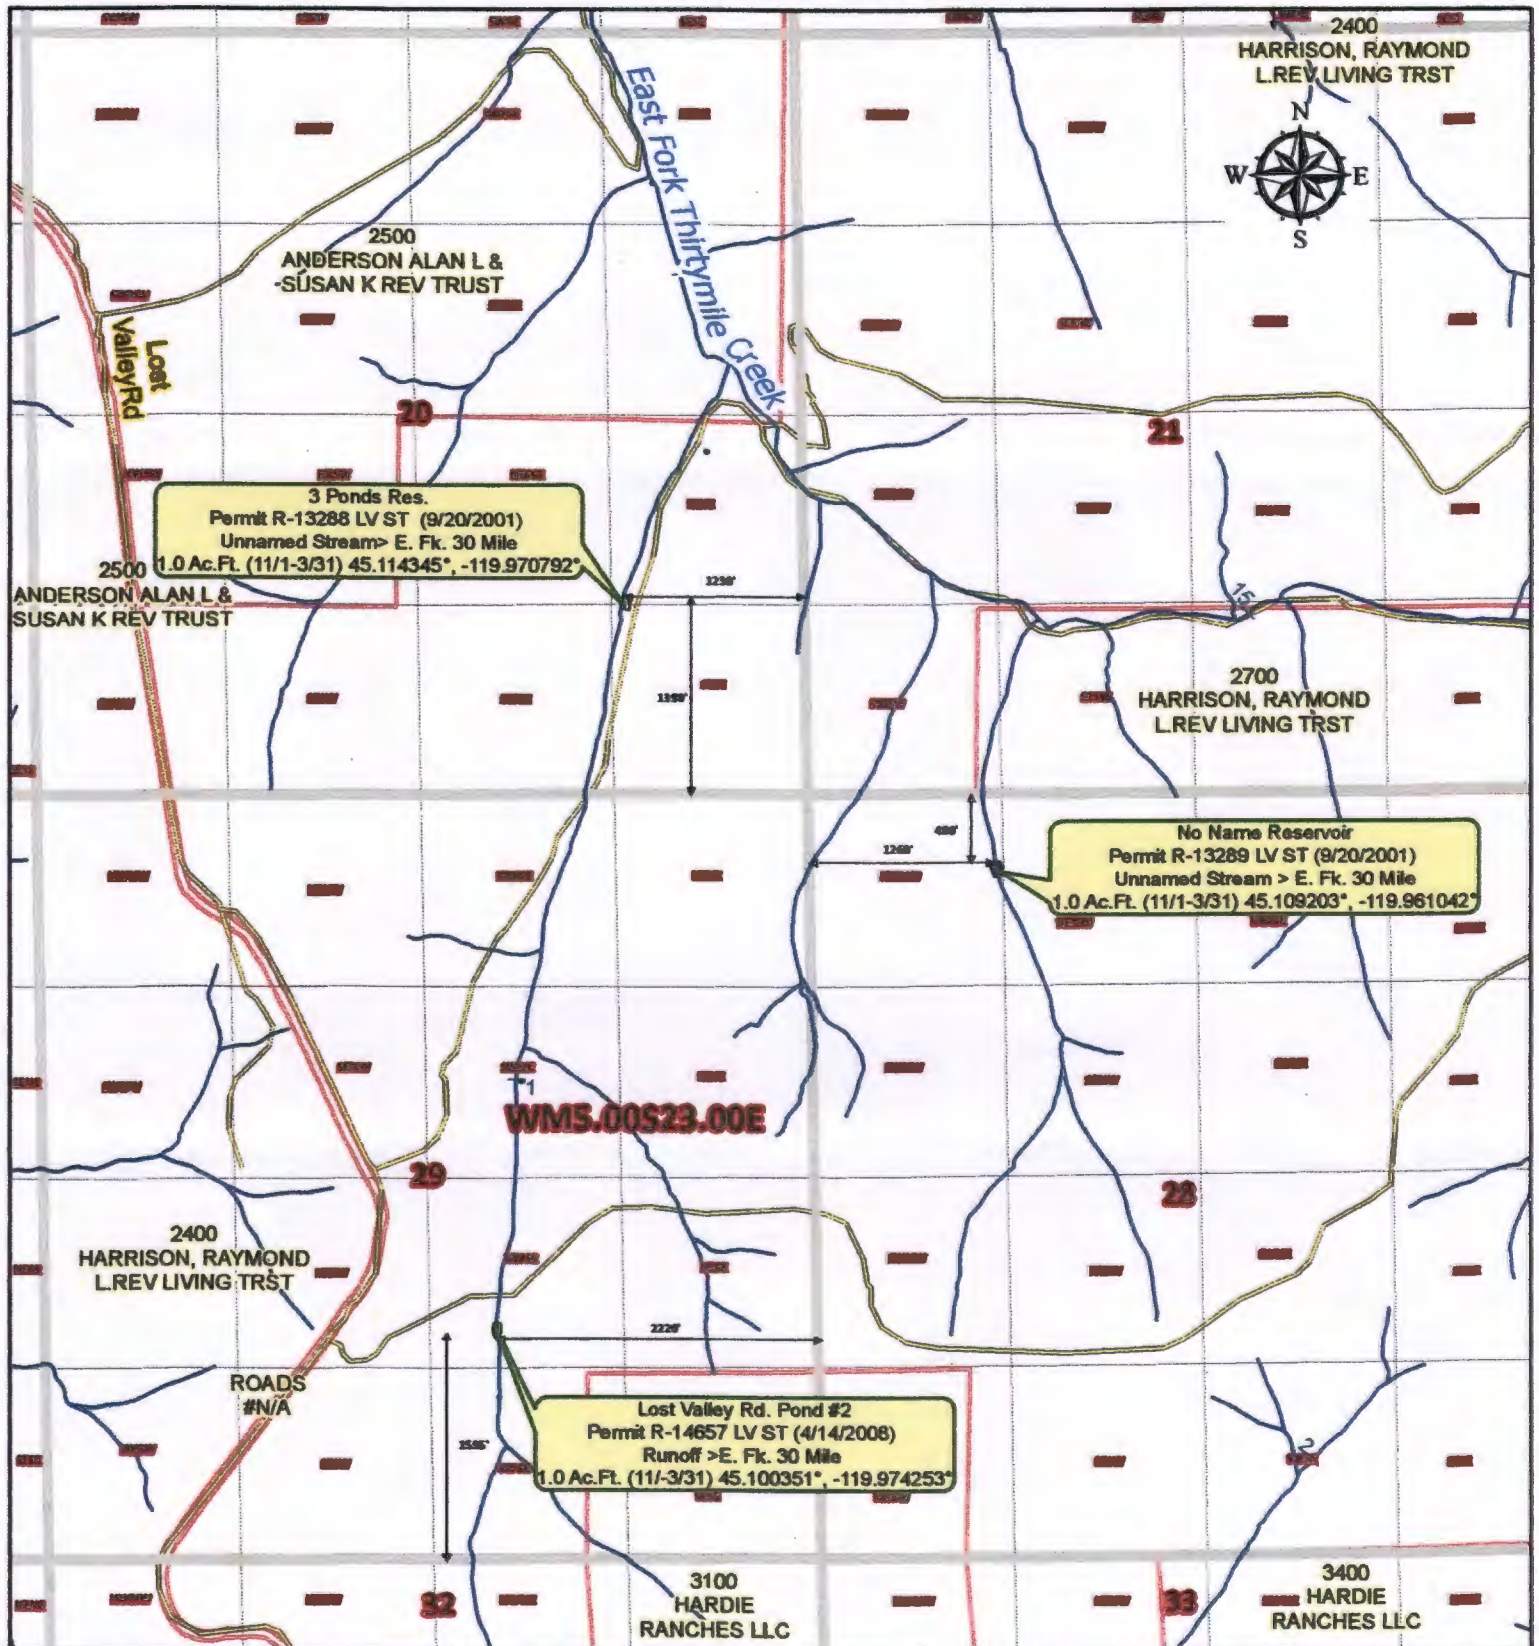

3 ponds Reservoir
5.00S-23.00E-20-NE SE

No Name Reservoir
5.00S-23.00E-28-NW NW

Lost Valley Rd. Pond #2
5.00S-23.00E-29-NW SE