


#2

Matthews Small Ponds Application

T 1 S, R 38 E, Section 15

11-5

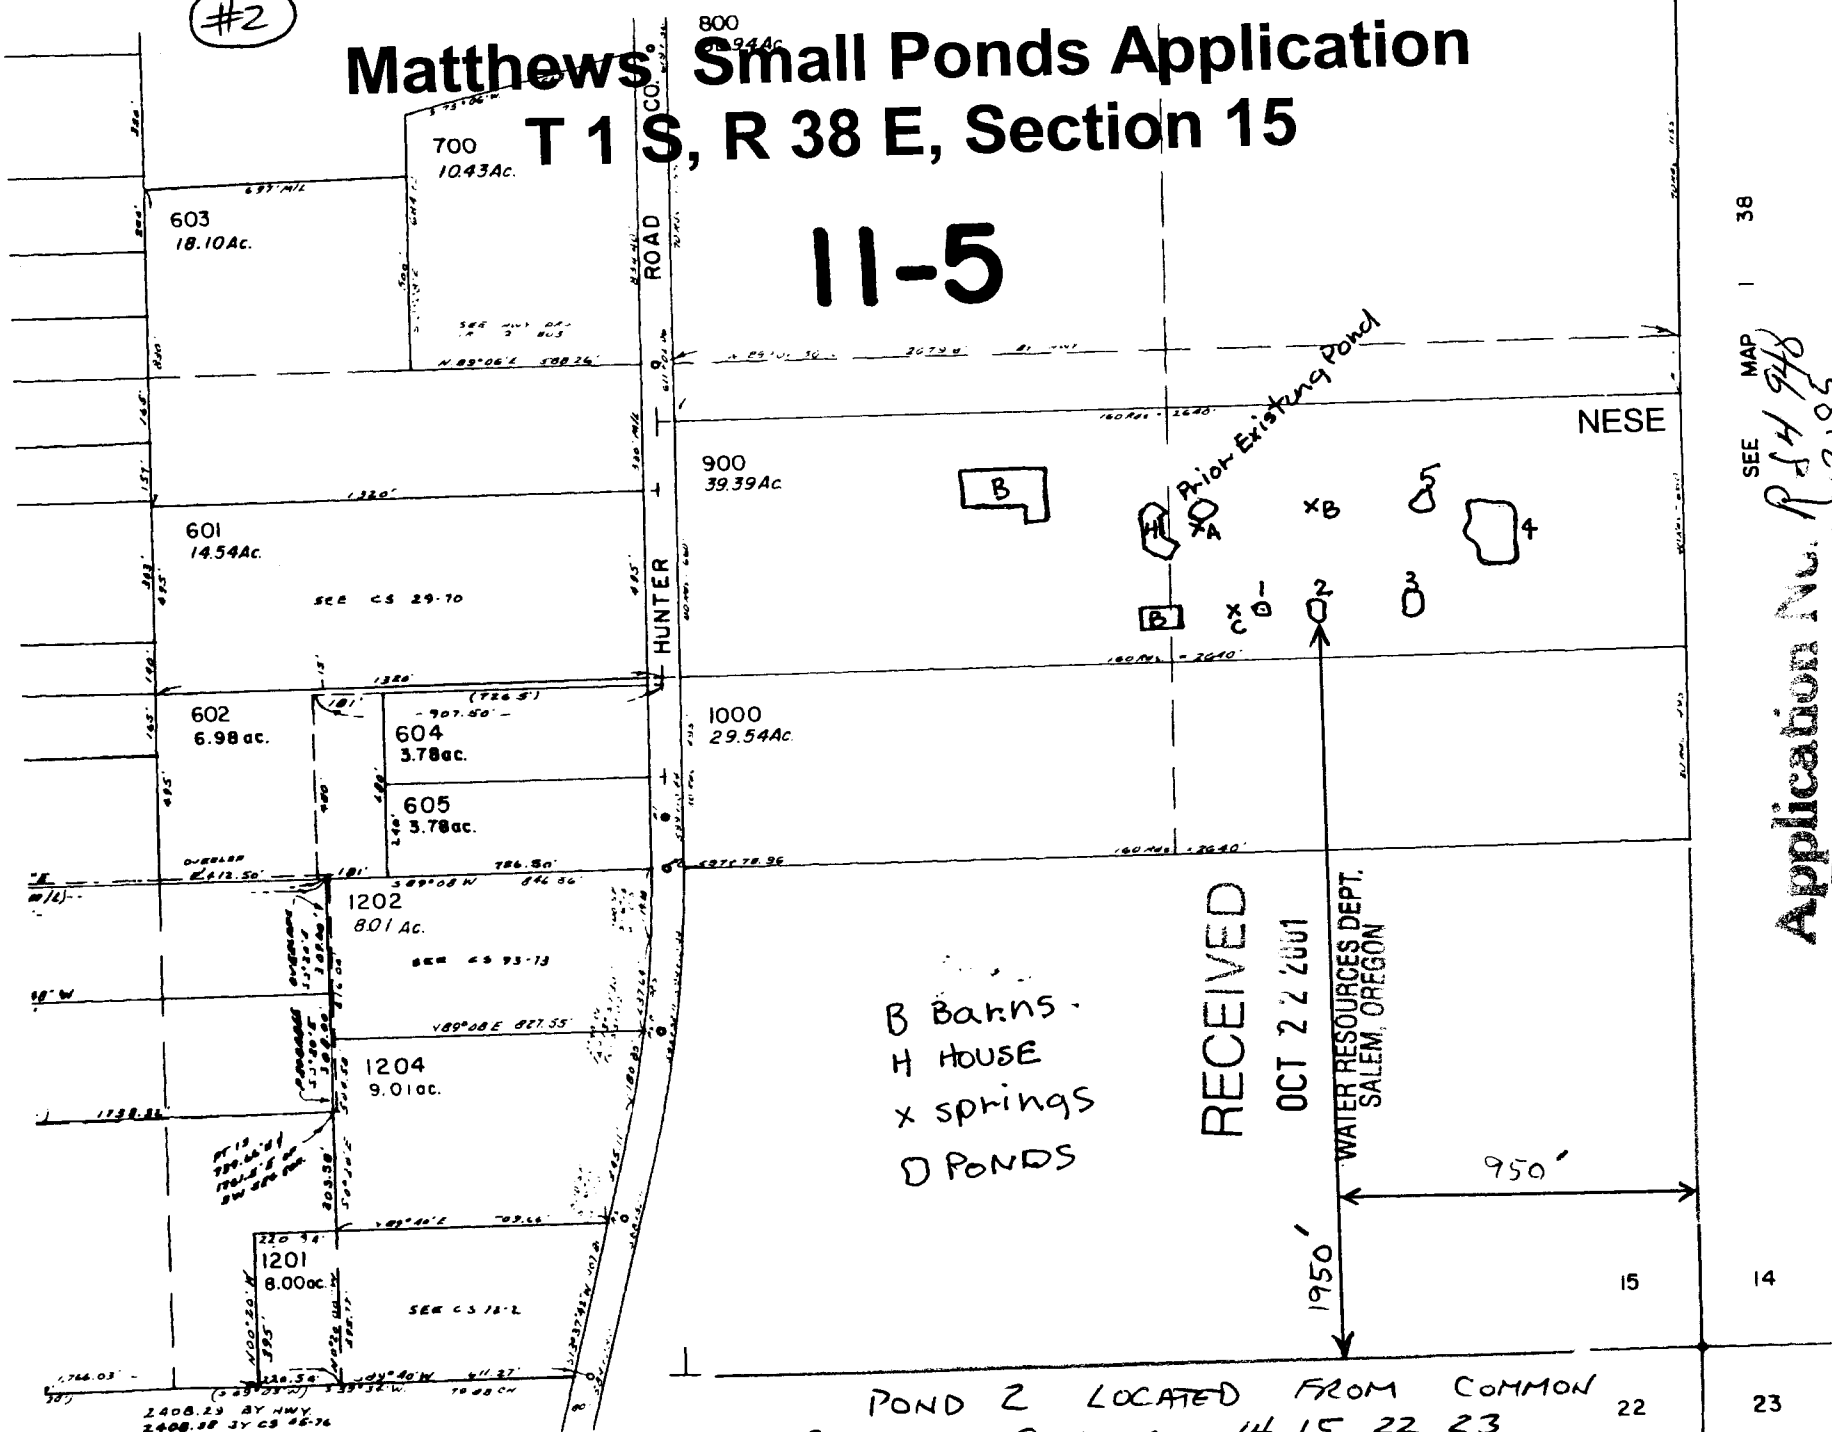

Scale 1" = 500'

POND 2 LOCATED FROM COMMON
SECTION CORNER 14, 15, 22, 23
950' WEST & 1950' NORTH

RECEIVED

OCT 22 2001

WATER RESOURCES DEPT.
SALEM, OREGON

38

SEE MAP

Application No. R-13185
Permit No. R-13185

