

T. 9 S., R. -
Scale 4" = 1 mile



Dead No
1000

RECEIVED BY OWRD

JUL 27 2015

SALEM, OR


WATER RESOURCES DEPT.
SALEM, OREGON

JAN 18 2002

RECEIVED

James M. Connor

Project #2 Pond is about
650' S. and 2300' E. of
NW corner Sec. 12

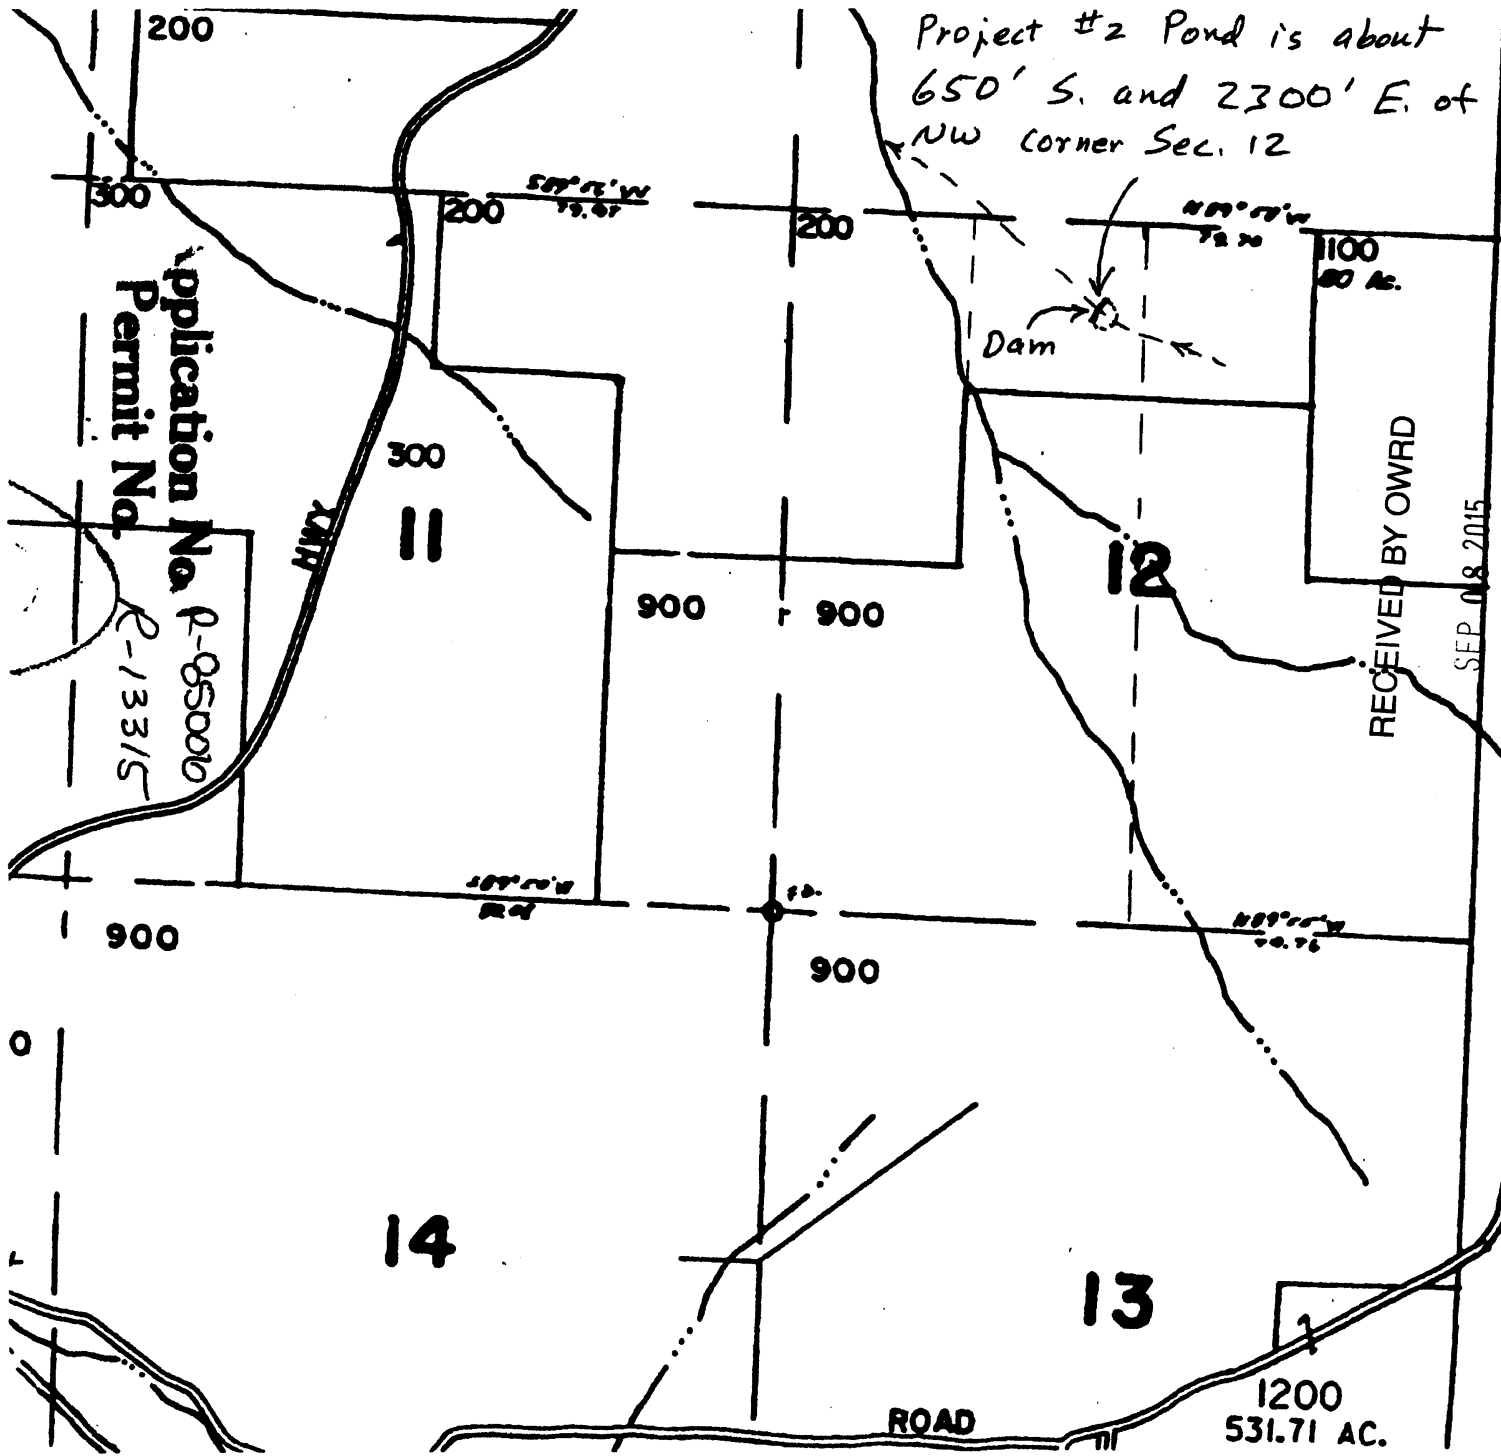

Application No. R-85006
Permit No. R-13315

RECEIVED BY OWRD

SEP 08 2015

SALEM, OR

Dam

ROAD

1200
531.71 AC.

14

13

12