


T. 24 S., R. 26 E., W.M.

RECEIVED

AUG 30 1999

WATER RESOURCES DEPT.
SALEM, OREGON

DIVERSION IS 2770
FEET SOUTH AND
890 FEET EAST
OF THE NW CORNER
OF SECTION 29.

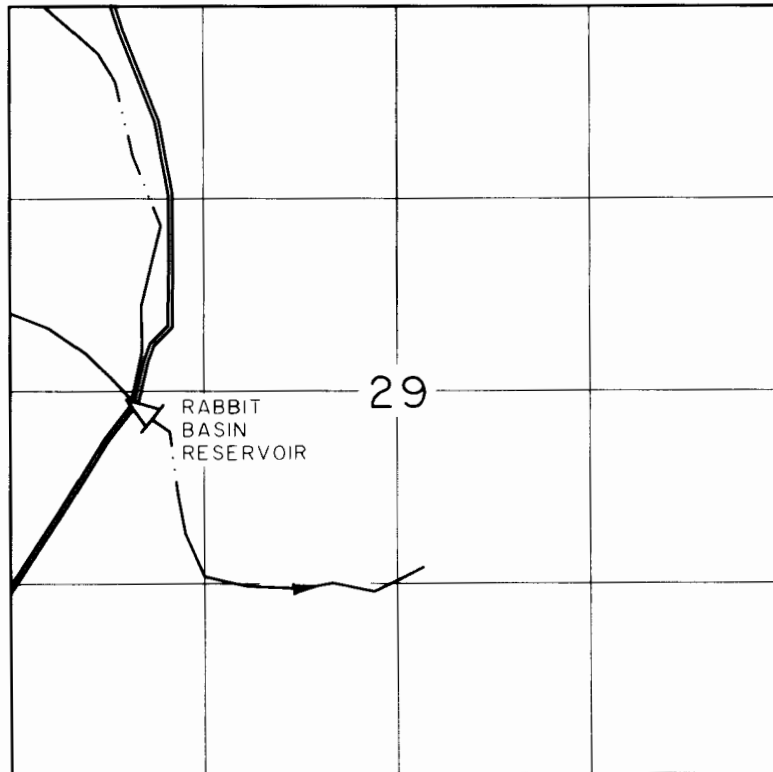

1" = 1320'


CLAIM OF BENEFICIAL USE MAP

IN NAME OF

UNITED STATES BUREAU OF LAND MANAGEMENT

APPLICATION NO. R-73148

PERMIT NO. R-II566

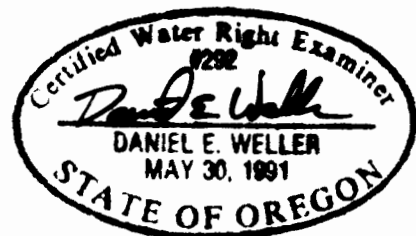

EXPIRES 6/30/00

SURVEYED: JUNE 15, 1999

THE PURPOSE OF THIS MAP IS FOR IDENTIFYING THE LOCATION OF THE WATER RIGHT ONLY AND
IS NOT INTENDED TO PROVIDE LEGAL DIMENSIONS OR LOCATION OF PROPERTY OWNERSHIP LINES.

U.S. BUREAU OF LAND MANAGEMENT-OSO
BRANCH OF GEOGRAPHIC SCIENCES

DWG: RABBIT

EXECUTED BY:
DANIEL E. WELLER, PLS, CWRE
P.O. BOX 2965
PORTLAND, OREGON 97208