# T. 24 S., R. 26 E., W.M.

RECEIVED
AUG 30 1999
WATER RESOURCES DEPT.
SALEM, OREGON

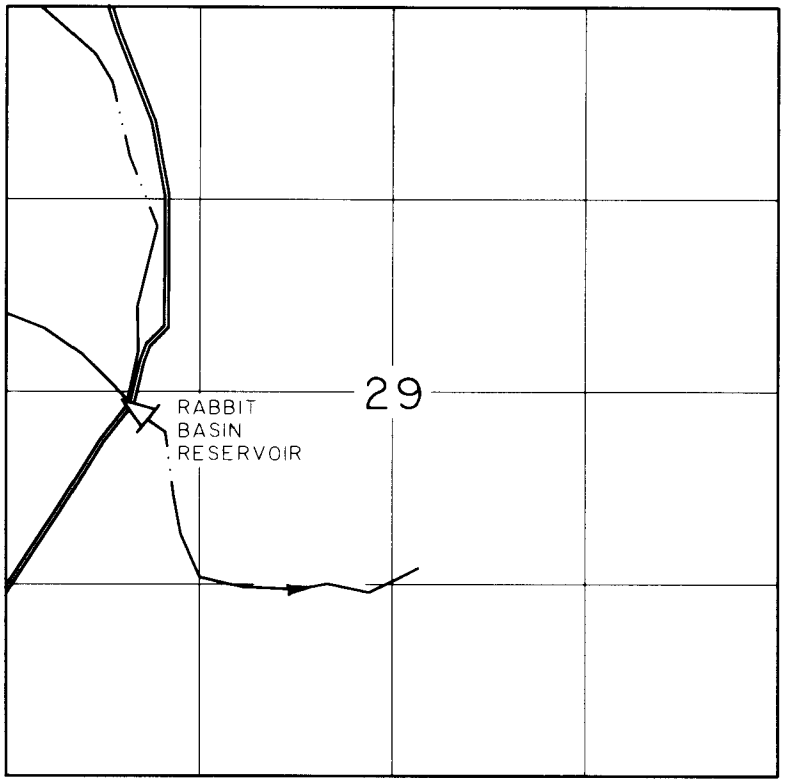


DIVERSION IS 2770 FEET SOUTH AND 890 FEET EAST OF THE NW CORNER OF SECTION 29.

1" = 1320'

## CLAIM OF BENEFICIAL USE MAP

IN NAME OF

## UNITED STATES BUREAU OF LAND MANAGEMENT

APPLICATION NO. R-73148

PERMIT NO. R-11566

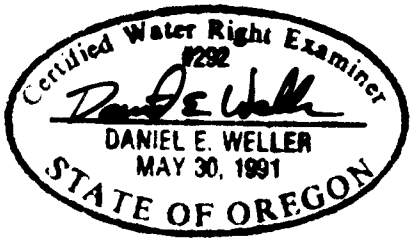


EXPIRES 6/30/00

SURVEYED: JUNE 15, 1999

THE PURPOSE OF THIS MAP IS FOR IDENTIFYING THE LOCATION OF THE WATER RIGHT ONLY AND IS NOT INTENDED TO PROVIDE LEGAL DIMENSIONS OR LOCATION OF PROPERTY OWNERSHIP LINES.

| | |
|---|---|
| U.S. BUREAU OF LAND MANAGEMENT-OSO<br>BRANCH OF GEOGRAPHIC SCIENCES<br><br>DWG: RABBIT | EXECUTED BY:<br>DANIEL E. WELLER, PLS, CWRE<br>P.O. BOX 2965<br>PORTLAND, OREGON 97208 |