

CLAIM OF BENEFICIAL USE MAP FOR T-10726



N 1/4 SEC 4

SECTION 4, T2N, R2W, WM.
WASHINGTON COUNTY, OREGON

NW HANSEN ROAD

225)

SM/L

740'

380'

POD = DAM FOR
SCHMIDT
RESERVOIR

1307.32 PROPERTY LINE

101
38.34 AC

TL 103

NW NE
Gov
lot 2

SW NE

PROPERTY LINE

501.39

1304.36

102
38.37 AC

NE NE
Gov lot 1

LOT
42.40 AC

33 34
4 3

501.4

84.91 RODS

RECEIVED

OCT 17 2011

WATER RESOURCES DEPT
SALEM, OREGON


THIS MAP WAS PREPARED FOR
THE PURPOSE OF IDENTIFYING
THE LOCATION OF A WATER
RIGHT ONLY AND IS NOT
INTENDED TO PROVIDE LEGAL
DIMENSIONS OR LOCATION OF
PROPERTY OWNERSHIP LINES.



EXPIRES 6/30/2012



Project: 307-2-080
Drawing: 3072080D.dwg
By: URSTADT
Date: 5OCT2011

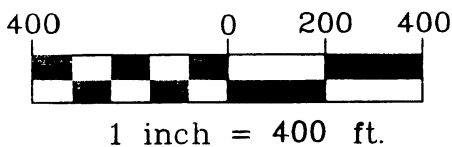

MAP BASE:
ASSESSOR MAP 2N2B AND
GOOGLE IMAGE DATE 14AUG2010