
** pplication No. R. 85/65
Permit No. R-19435

TAX LOT 06401

SOUTH EAST QUARTER OF SECTION 25 TIN R32E

NORTH

SCALE 1"=660' POND TWO

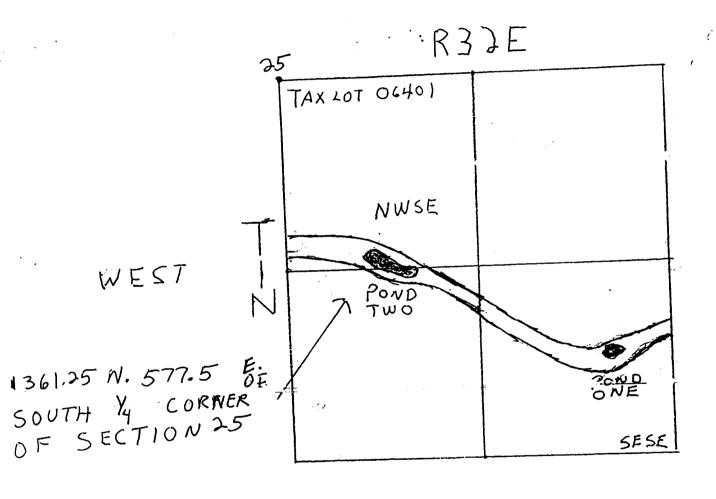

EAST

SOUTH

RECEIVED
MAY 0 6 2002

WATER RESOURCES DEPT. SALEM, OREGON