


T.24S., R.29E., W.M.  
HARNEY CO., ORE.

**RECEIVED**

JUL 17 2000

WATER RESOURCES DEPT.  
SALEM, OREGON

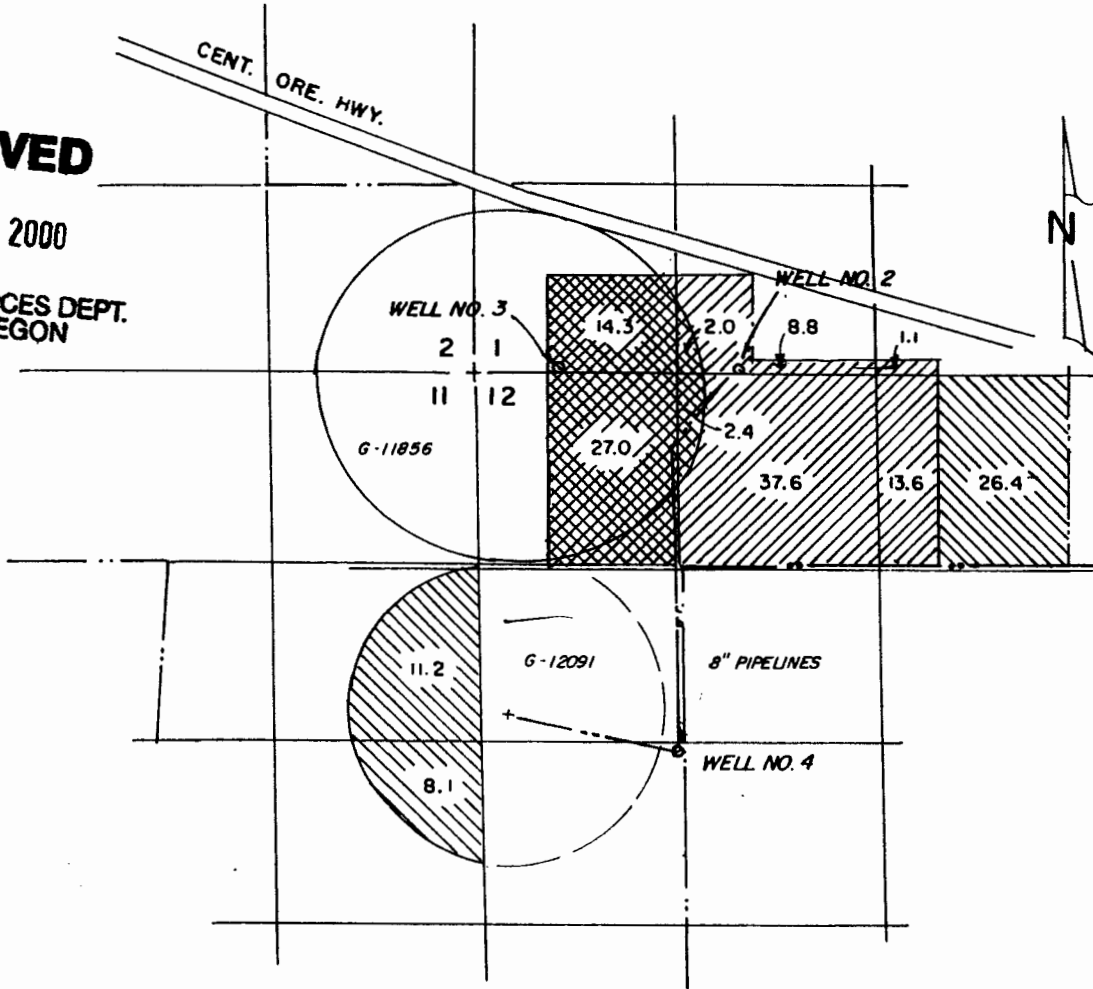

WATER RIGHTS TRANSFERRED FROM



WATER RIGHTS TRANSFERED TO



WATER RIGHTS REMAING UNDER G - 7838

THE PURPOSE OF THIS MAP IS TO IDENTIFY THE LOCATION OF THE WATER RIGHT. IT IS NOT INTENDED TO PROVIDE INFORMATION RELATIVE TO THE LOCATION OF PROPERTY OWNERSHIP.

JOHN & CAROLYN BAUER

BURNS, OREGON

**FINAL PROOF MAP**

APPLICATION T-6799

Scale: 1" = 1320'

Date: JULY 6, 2000

Job: 1110

Den:

Drn: CORK .

Ckd: -




M. A. PALMER & SONS, INC.  
ENGINEERING & SURVEYING  
254 N. Alder - Box 61  
Burns, Oregon 97720

Sht. No.

of 1

1

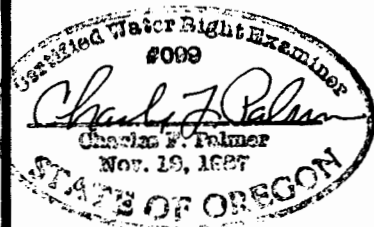

RENEWAL 1/1/01