


Scale: 1"=400'

Note: The preparation of this map was for the purpose of identifying the location of the proposed water right and has no intent to provide dimensions or locations of property ownership lines.


- LEGEND -

- Adjusted Property Line
- Mainline
- ⊗ Proposed Div. Pt. #1 (69.5 Ac.)
- Proposed Div. Pt. #2 (66.1 Ac.)
- Pump
- ▨ Cert. 25455 1863 (89.5 Ac. POD 1)
- ▧ Cert. 25455 1863 (35.1 Ac. POD 2)
- ▩ Cert. 52529 1870 (8.9 Ac. POD 2)
- Cert. 50367 1876 (3.3 Ac. POD 2)
- Cert. 21407 1950 (18.8 Ac. POD 2)

Note- The insets below are graphic representations of the historic POD's of the affected Water Rights. All lie within Township 13S., Range 31E., N.W.M.

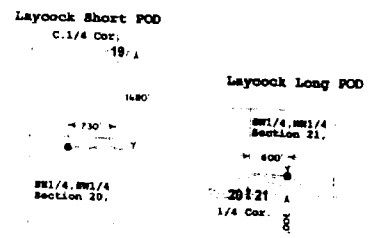

Final Proof Map  
for  
Water Right Transfer  
T-9472  
Proposed Place of Use  
and Point of Diversion  
for  
Vic Pike  
by

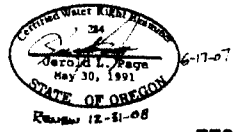

RECEIVED  
DEC 11 2007  
WATER RESOURCES DEPT  
SALEM, OREGON

COBU MAP # 0310

This map has been amended by OWRD to exclude 0.8 Ac from SW 1/4 SW 1/4, Sec. 19. Joyce/OWRD  
7-21-16

0310