


**CLAIM OF BENEFICIAL USE MAP  
TERRY AND SUSAN BRIDWELL  
TRANSFER APPLICATION T-10075  
TOWNSHIP 15 SOUTH, RANGE 10 EAST, W.M  
DESCHUTES COUNTY, OREGON**

Peterson Ridge Rd.

23 24

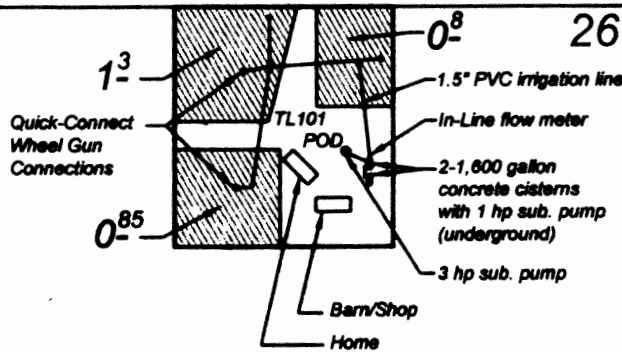

**Point of Diversion (POD) Location:  
Well located 600' W & 300' S of  
NE corner of Section 26**

 **Place of Use**

**RECEIVED**


APR 11 2008

WATER RIGHTS DIVISION  
DESCHUTES COUNTY

*This map is for the purpose of locating  
a water right only and has no intent  
to provide legal dimensions or the  
location of property lines.*



1" = 400'  
SCALE

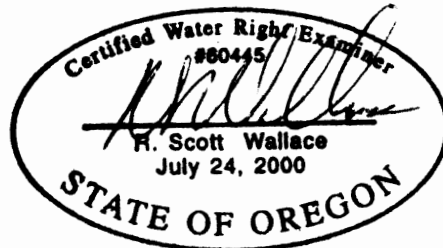

EXPIRATION DATE: 06/30/08

**KLEINFELDER**

Copyright 2008

GEOTECHNICAL AND ENVIRONMENTAL ENGINEERS  
SOILS AND MATERIALS TESTING

CLAIM OF BENEFICIAL USE MAP  
TERRY AND SUSAN BRIDWELL  
16751 PETERSON RIDGE ROAD  
SISTERS, OREGON

PROJECT # 86214 (A01)

FIGURE 1