


SCALE 1" = 400'

CLAIM OF BENEFICIAL USE  
FOR: RACHEL INGE  
BY: DUANE W. KIRBY  
T29S, R7W, SEC 16& 21 WM  
APPLICATION NO S-84162  
PERMIT NO S-53938  
FISH SCREEN IS LOCATE AT POD  
METER IS LOCATED 10' FROM POD  
TAX LOT 200&1000

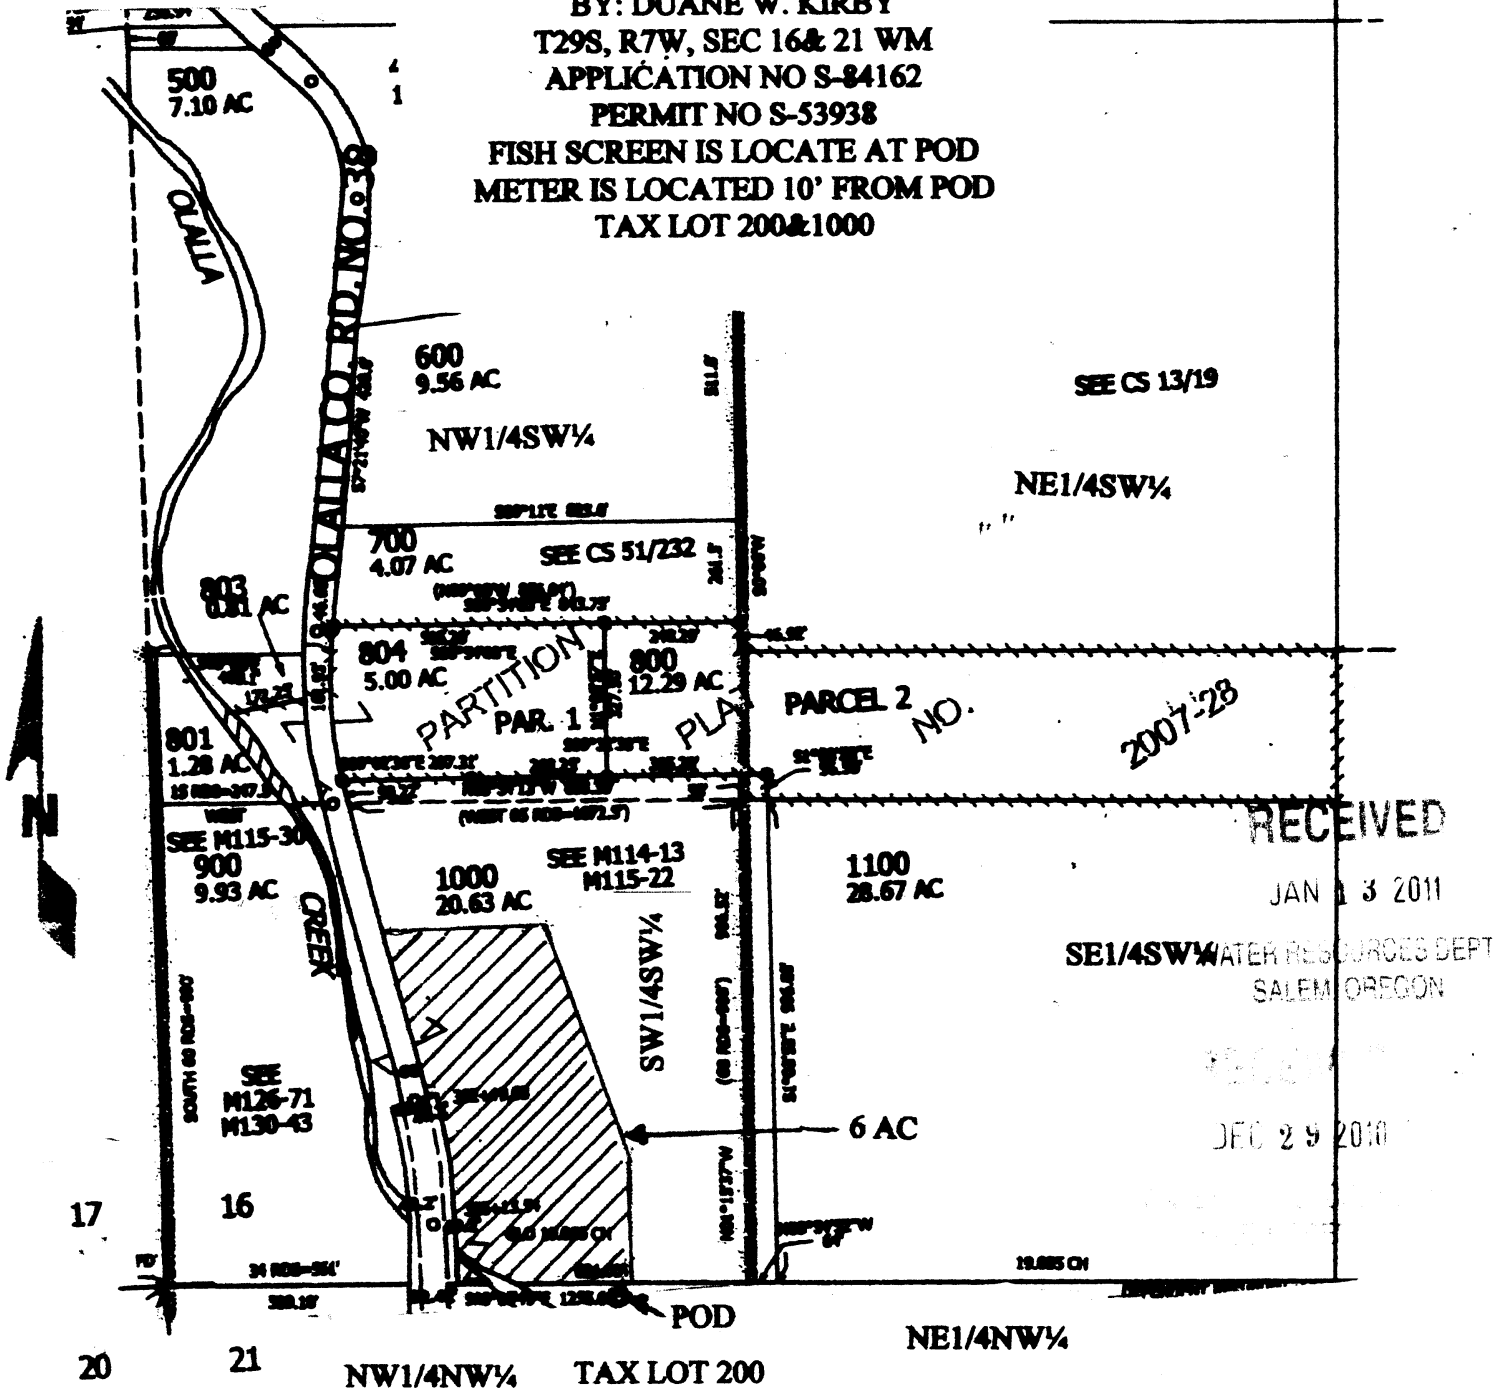

POINT OF DIVERSION LOCATION: NW 1/4 NW 1/4, SECTION 21, T29S, R7W, W.M.; 30 FEET SOUTH & 940 FEET EAST FROM NW CORNER SECTION 21

THE PURPOSE OF THIS MAP IS TO IDENTIFY THE LOCATION OF THE WATER RIGHT. IT IS NOT INTENDED TO PROVIDE INFORMATION RELATIVE TO THE LOCATION OF PROPERTY OWNERSHIP BOUNDARY LINES.

