

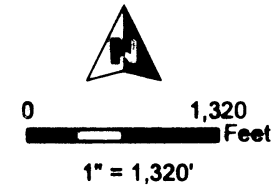


**T25S, R14E
SECTION 21, WM**

LAKE COUNTY, OREGON

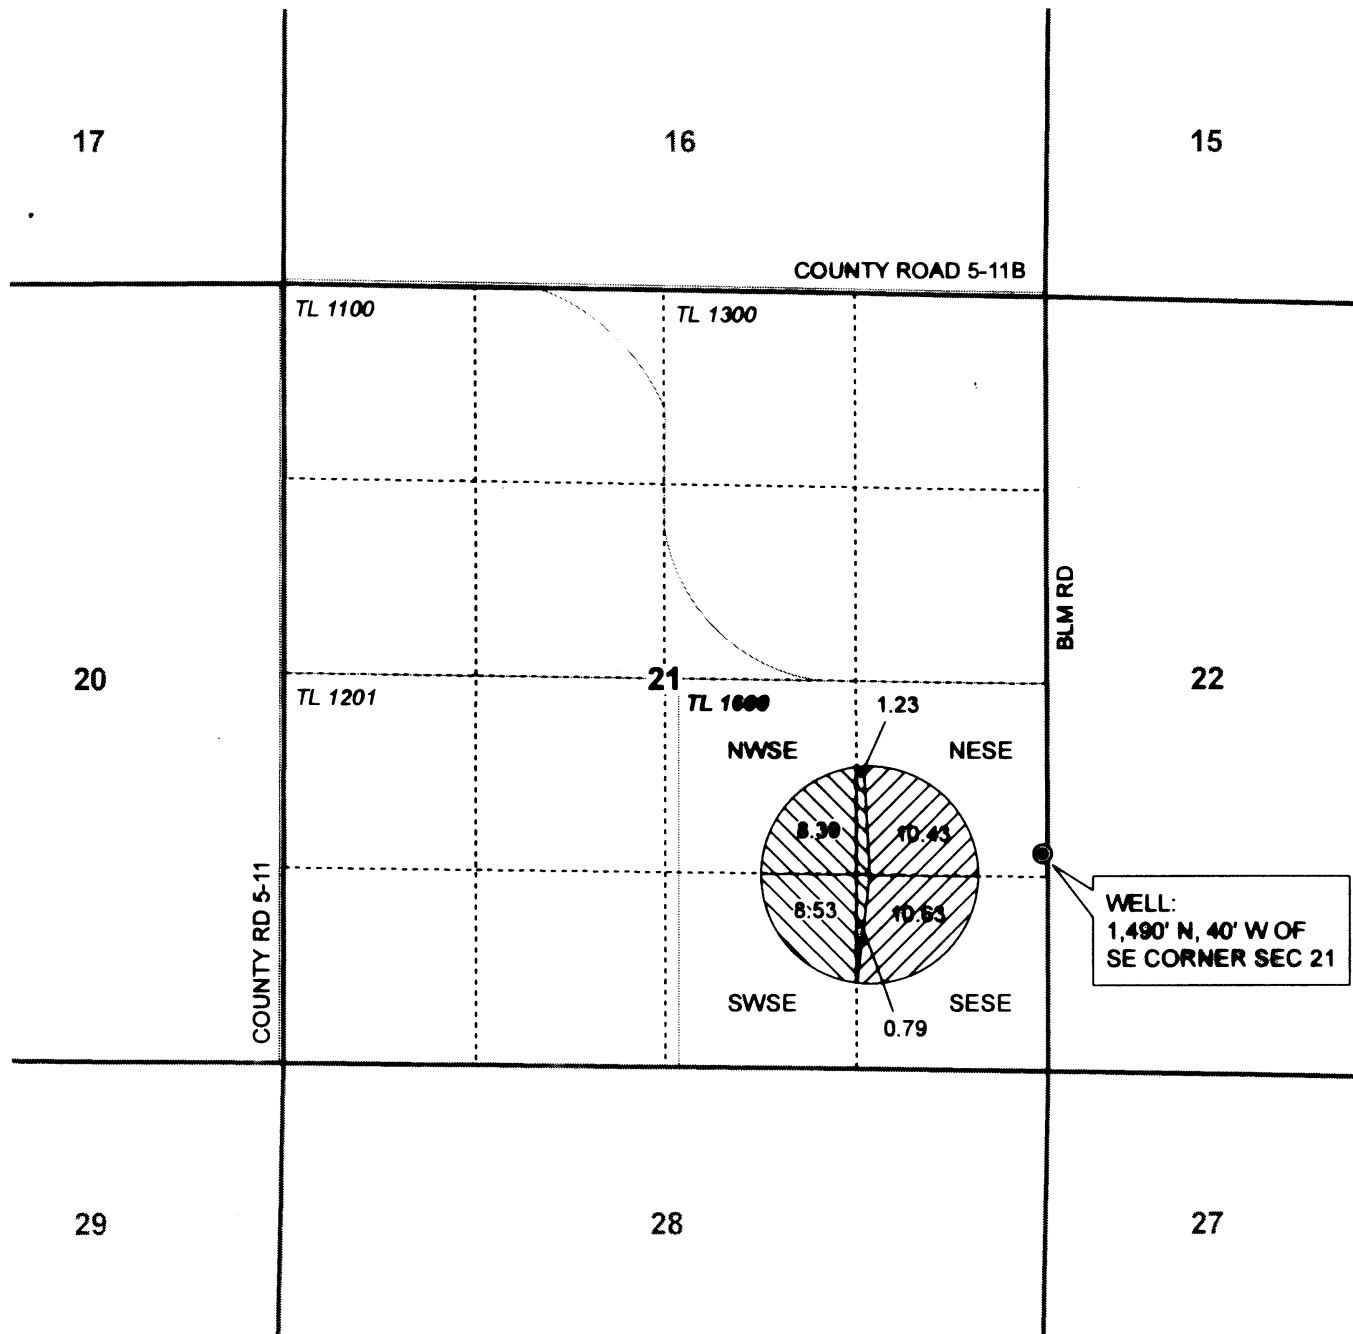

- POU for June 11, 1973 (18.94 ac)
- POU for Jan 8, 1976 (21.06 ac)
- Section
- Quarter Quarter
- Taxlot
- Well

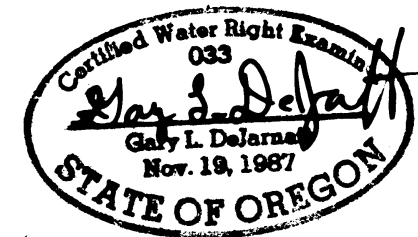

RECEIVED BY OWNER DATE 12/31/2015

JAN 23 2015

SALEM, OR



CLAIM OF BENEFICIAL USE MAP
Renner

TRANSFER T-8889

NOTE: THIS MAP IS NOT INTENDED TO
PROVIDE LEGAL DIMENSIONS OR LOCATIONS
OF PROPERTY OWNERSHIP LINES.

PROJECT #14091

DECEMBER 3, 2014

WATER RIGHT SERVICES, LLC
PO BOX 1830, BEND, OR 97709
CCB# 197121 www.oregonwater.us
541-389-2837 JOHNSHORT@USA.COM