


**T25S, R14E
SECTION 21, WM**


LAKE COUNTY, OREGON

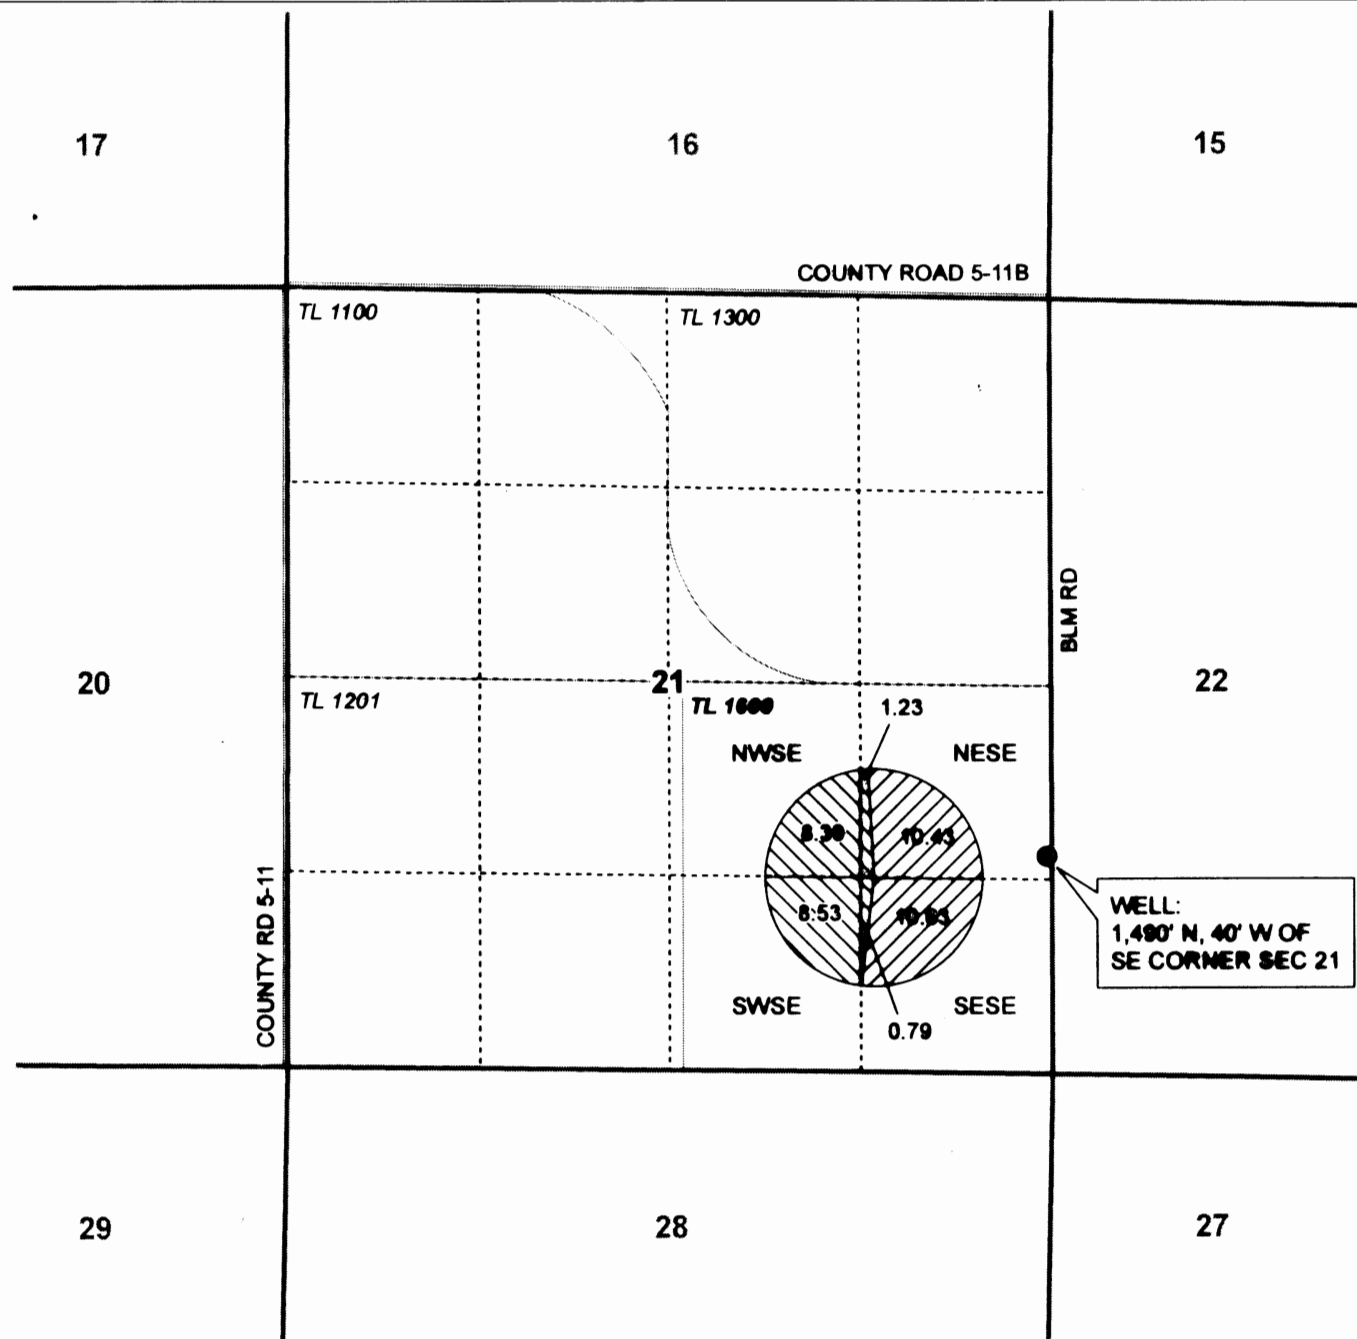

0 1,320 Feet

1" = 1,320'

-  POU for June 11, 1973 (18.94 ac)
-  POU for Jan 8, 1976 (21.06 ac)
-  Section
-  Quarter Quarter
-  Tardot
-  Well

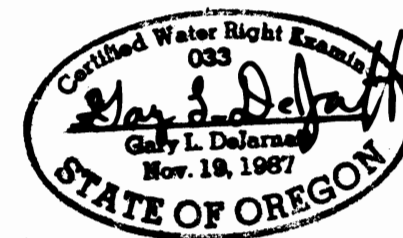

RECEIVED BY OWNER DATE 12/31/2015

JAN 23 2015

SALEM, OR



CLAIM OF BENEFICIAL USE MAP
Renner

TRANSFER T-8889

NOTE: THIS MAP IS NOT INTENDED TO
PROVIDE LEGAL DIMENSIONS OR LOCATIONS
OF PROPERTY OWNERSHIP LINES.

PROJECT #14091

DECEMBER 3, 2014

WATER RIGHT SERVICES, LLC
PO BOX 1830, BEND, OR 97709
CCB# 197121 www.oregonwater.us
541-389-2837 JOHNSHORT@USA.COM