


SECTIONS 16 & 17, TWP.2 N. RANGE 13 E. W.M.
WASCO COUNTY, OREGON

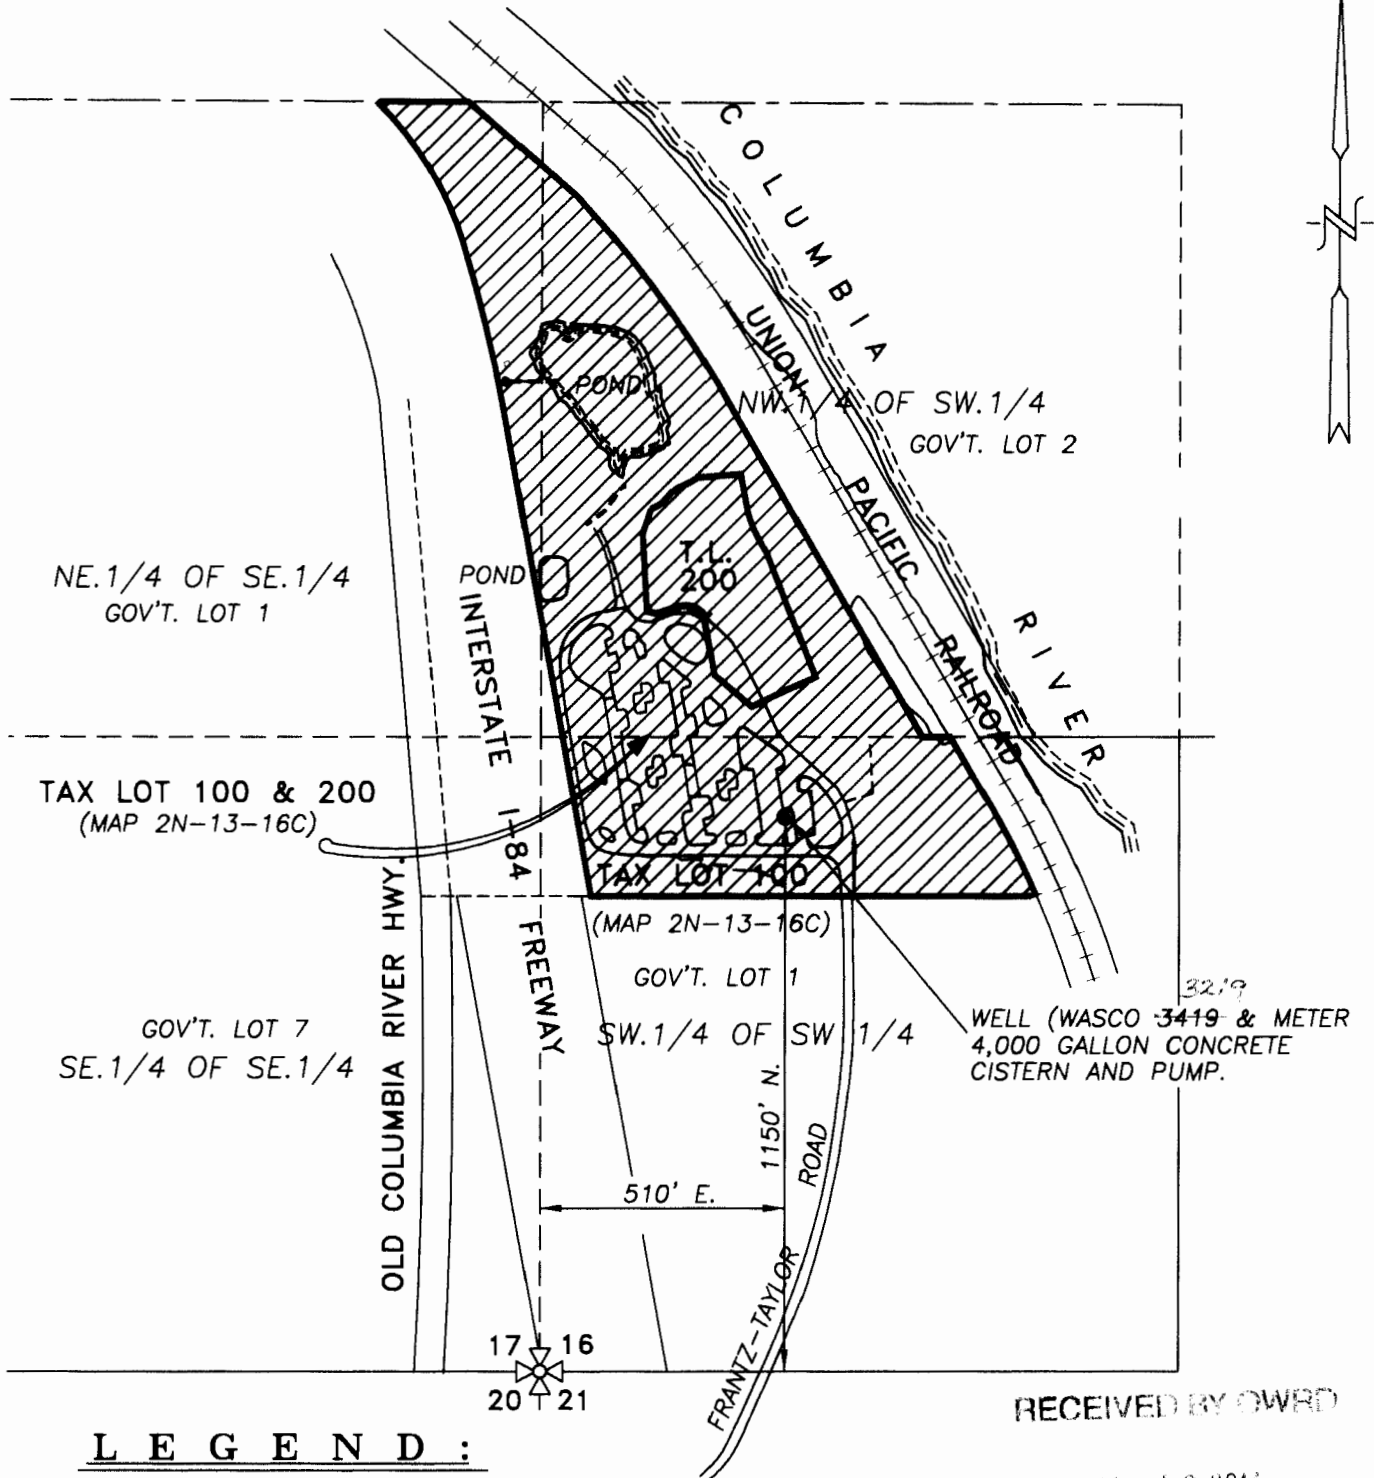


LEGEND:



MUNICIPAL USE AREA = 20.21 AC. (TOTAL)

CLAIM OF BENEFICIAL USE MAP

SCALE: 1" = 400'

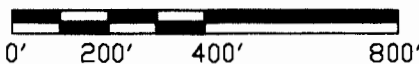

TRANSFER No. 7822


IN THE NAME OF:

WASCO COUNTY

DATE: MAY 8, 2014

BY: **TENNESON ENGINEERING CORP.**

3775 CRATES WAY
THE DALLES, OREGON. 97058
PH. 541-296-9177
FAX 541-296-6657

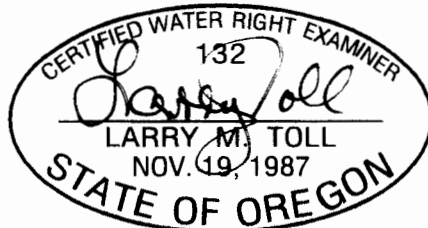

EXPIRES: 06/30/2014

NOTE:

"THIS MAP IS NOT INTENDED TO PROVIDE DIMENSIONS OR LOCATIONS OF PROPERTY OWNERSHIP LINES."

W.O. #8431wrt2

WRD revised map to reflect Well Log as WACO 3217. 7-15-16