

RECEIVED BY OWRD

OCT 19 2015

SALEM, OR

AS PER CONVERSATION
WITH ROGER WRIGHT
A.M. 11/12/02
HE WILL ASSIST IN
LOCATING QUADRANT

RECEIVED

NOV 25 2002

WATER RESOURCES DEPT.
SALEM, OREGON

RECEIVED BY OWRD

OCT 05 2015


SALEM, OR

SECTION 14 T.14N. R.12E. W.M. 14
COLUMBIA COUNTY
THIS MAP HAS BEEN PREPARED FOR ASSESSMENT PURPOSES ONLY
Current Revision Date: 11, 14, 01

Permit # R-85352
app # R-85352

CS# 63
CS# 3484

1" = 200'

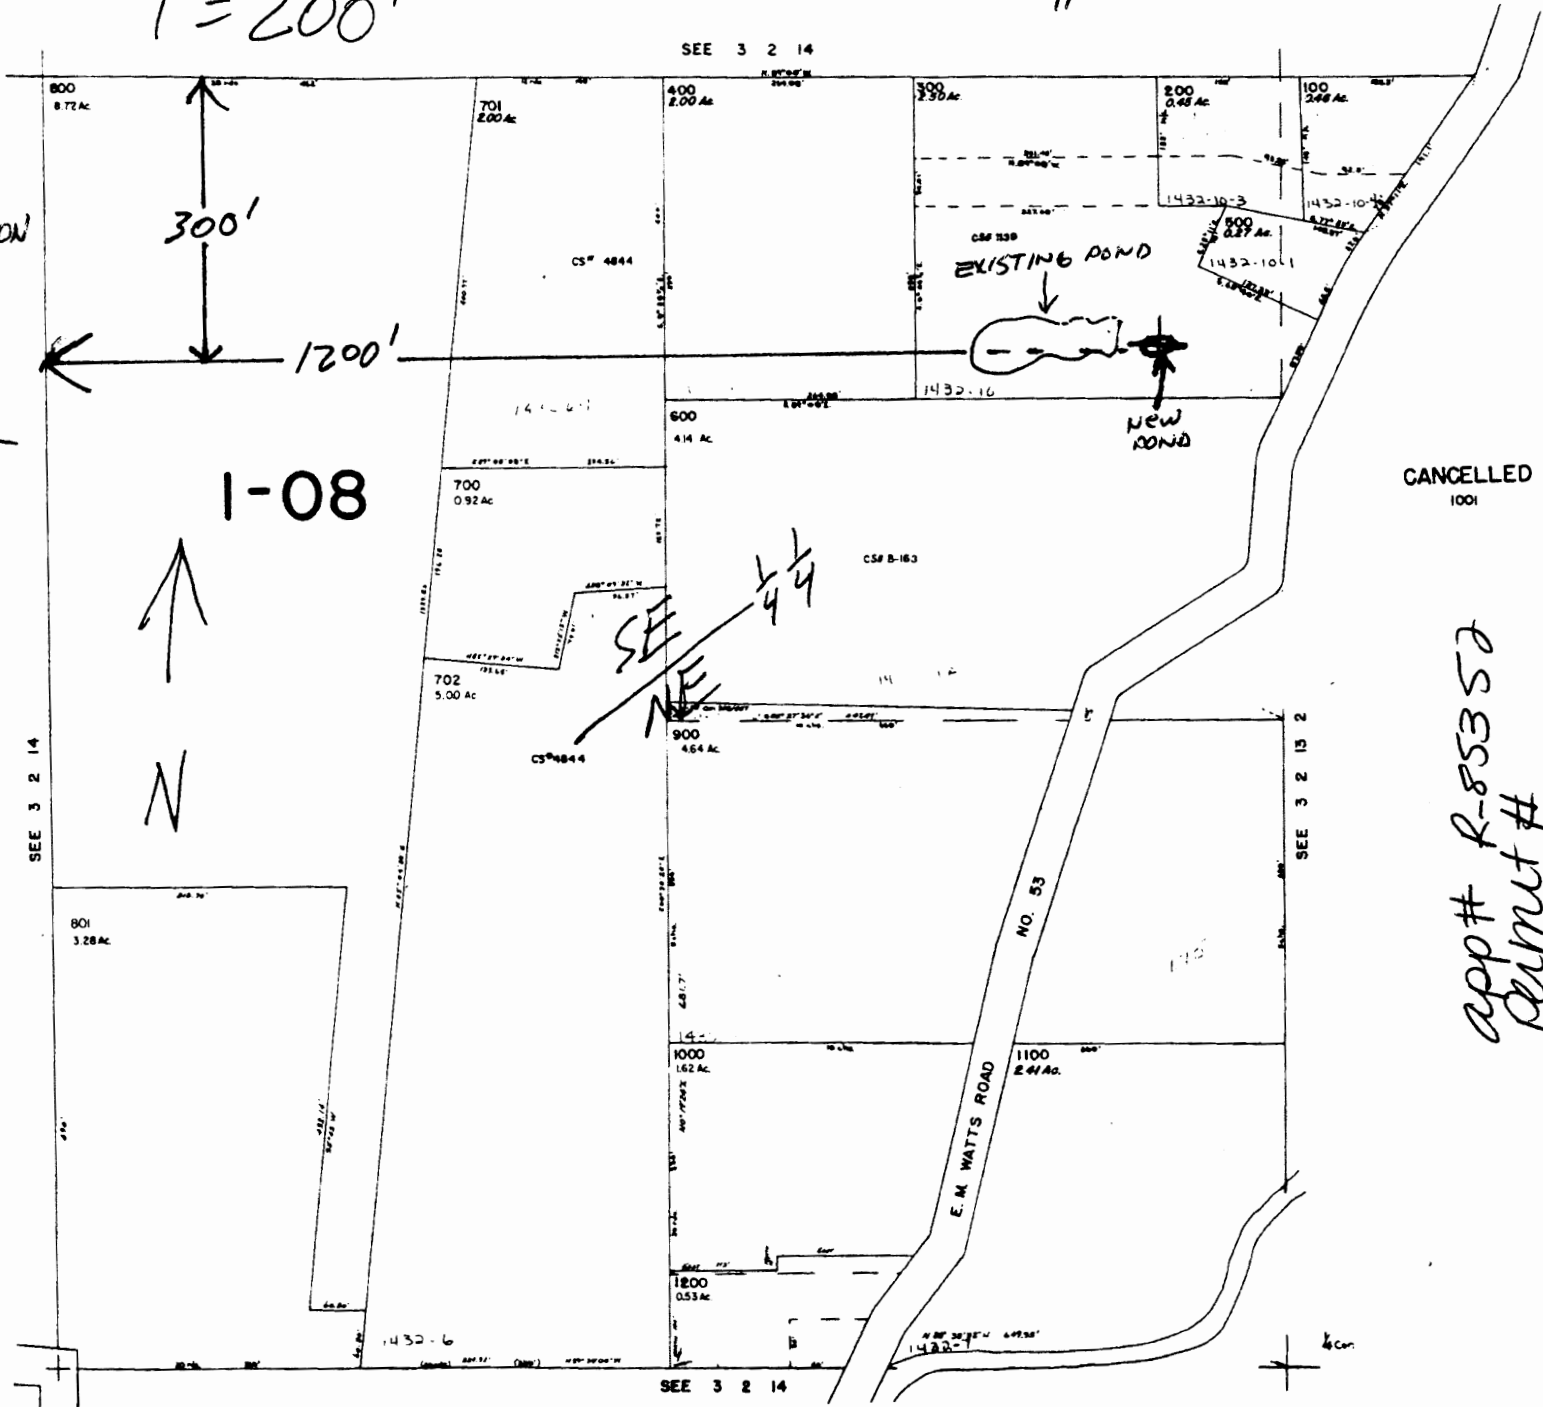

CANCELLED
1001

app # R-85352
Permit #