


SCALE: 1"=1320'

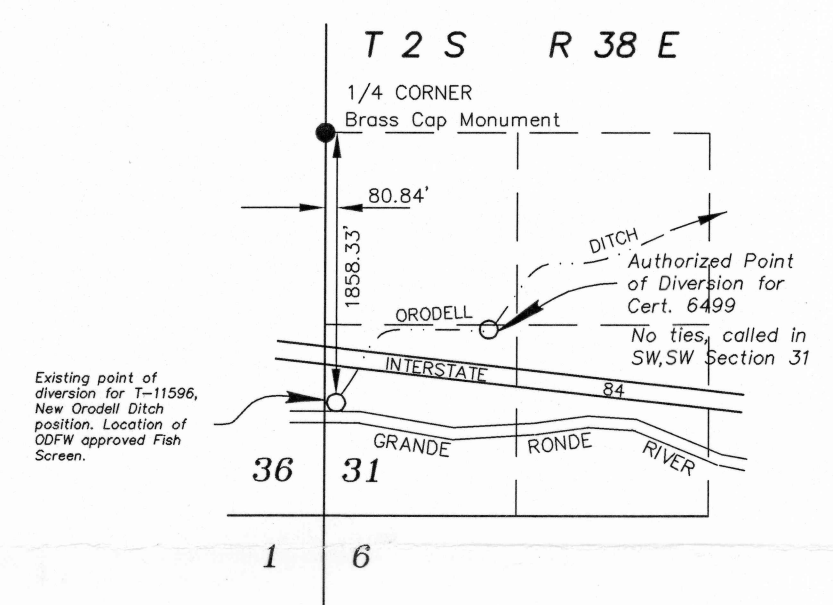

SCALE: 1"=1320'
 AUTHORIZED POINT OF DIVERSION
 FOR T-11596
 ORODELL DITCH


June 4, 2014

**CLAIM OF BENEFICIAL USE FOR
 PLACE OF USE AND POINT OF DIVERSION
 OF SURFACE WATER UNDER T-11596
 FOR
 AUSTIN AND JEANA BINGAMAN**

BY
 GREG BLACKMAN WATER RIGHTS
 126 RIDGE DRIVE
 LA GRANDE, OREGON 97850

APPLICATION NO. T-11596
 PERMIT NUMBER _____

RECEIVED BY OWRD
 JUN 17 2014
 SALEM, OR

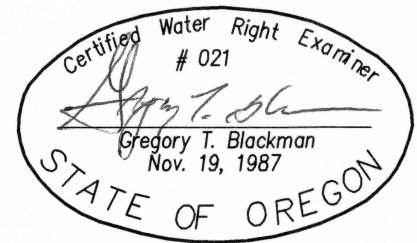

NOTE: The preparation of this map was for the purpose of identifying the location of the proposed water right and has no intent to provide dimensions or location of property ownership lines. Location information shown hereon was furnished by the applicant.

COBU MAP # 837