



T. 3S., R. 5E., S.W. 1/4 SEC. 18 W.M.

THE PURPOSE OF THIS MAP IS TO IDENTIFY THE LOCATION OF THE WATER RIGHT. IT IS NOT INTENDED TO PROVIDE INFORMATION RELATIVE TO THE LOCATION OF PROPERTY OWNERSHIP OR BOUNDARY LINES.

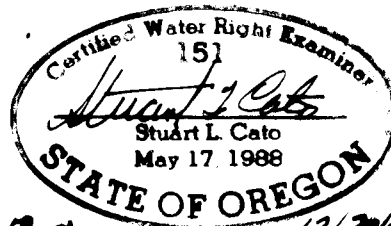

Revised

12/3/09

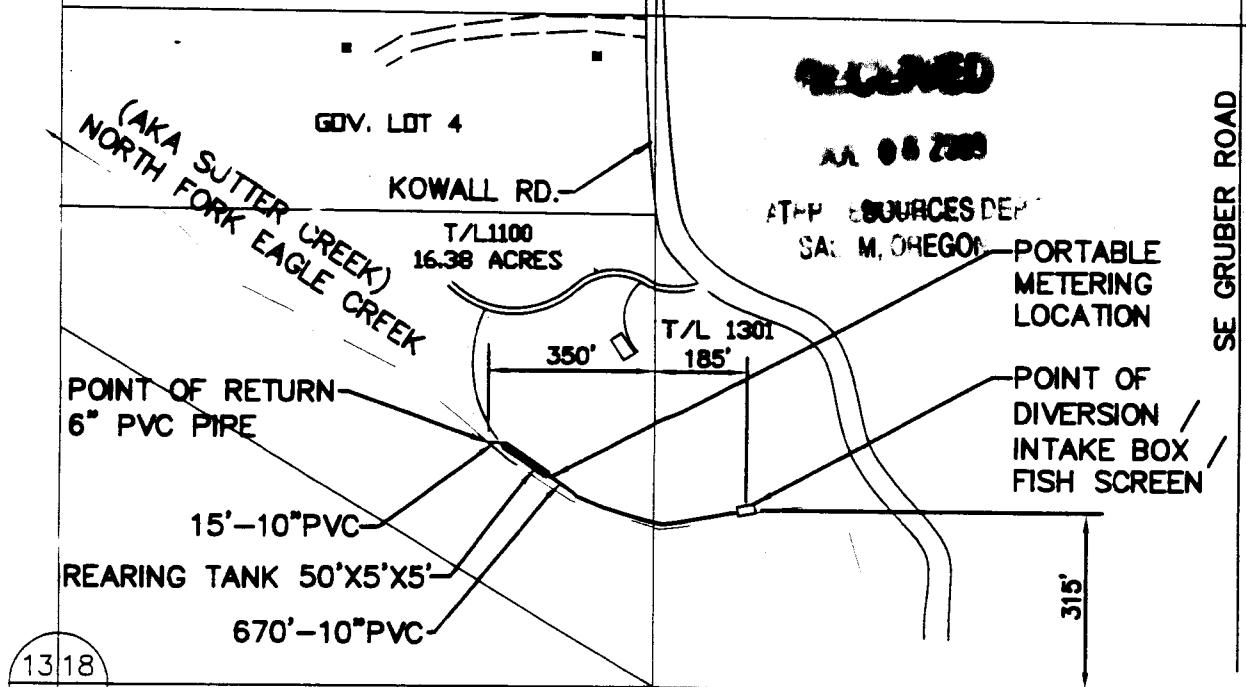

1318  
2419

FINAL PROOF SURVEY

UNDER

APPLICATION NO. T-10474

IN NAME OF

DAVID A. AND MARY A. BUGNI



SCALE: 1"=400'

Sica CONSULTING  
CIVIL ENGINEERS  
8555 SW Katherine Lane,  
Portland, Oregon 97225  
tel 503.292.0386; fax 503.292.0383

SURVEYED

BY

CWRE-151

DRAWN BY: CCV

JOB NO.: 91007.01

DATE: 6/18/09

91007-3

DRAWING NO.