


T 23 S, R 32 E, WM

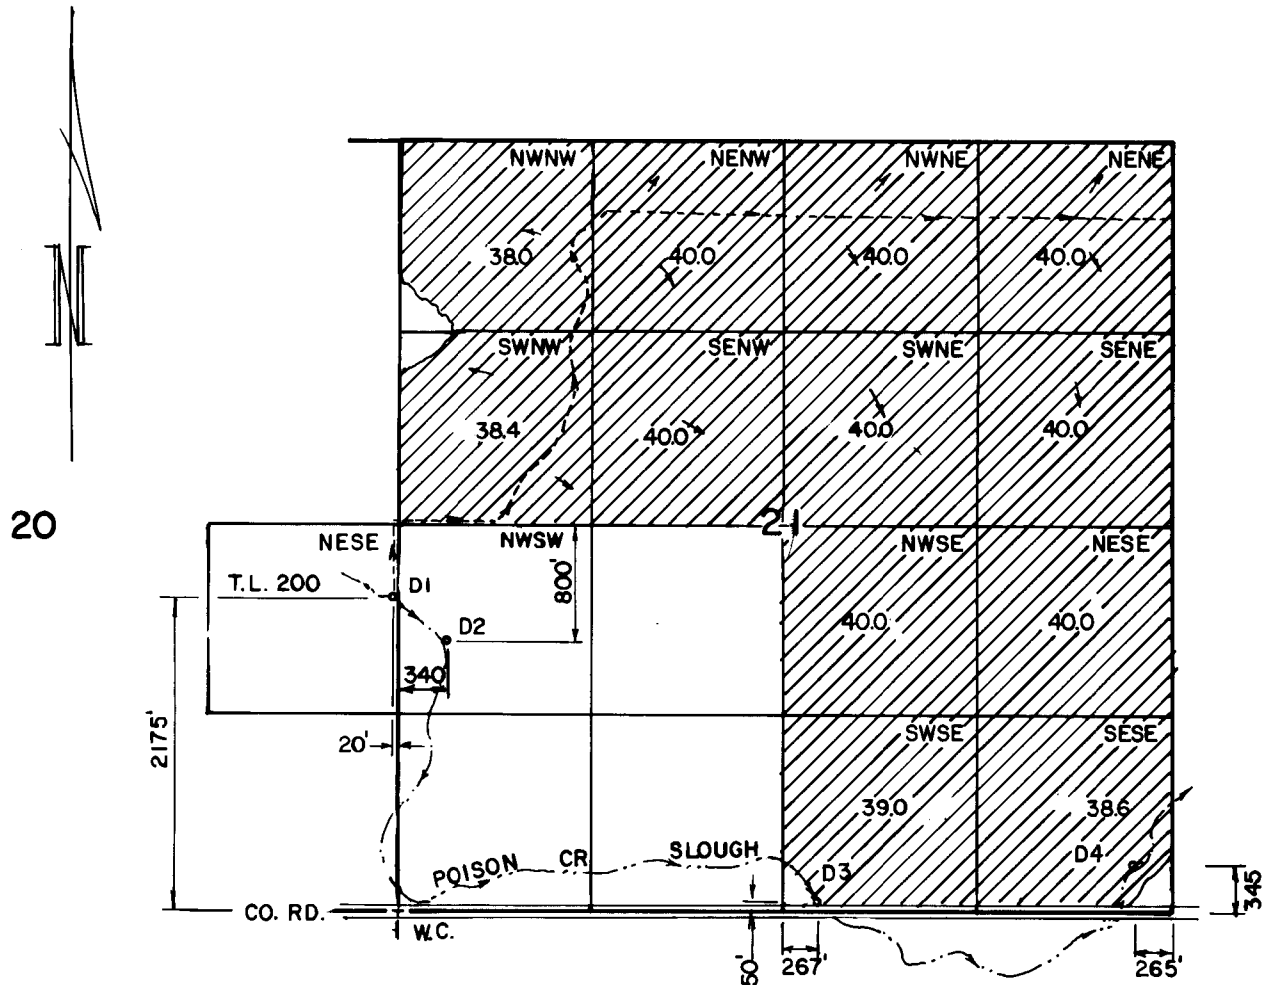


NW1/4 OF SEC. 21 IS T.L. 3500.
E1/2 OF SEC. 21 IS T.L. 3700.

RECEIVED

DEC 26 2006

WATER RESOURCES DEPT
SALEM, OREGON

THE PURPOSE OF THIS MAP IS TO
IDENTIFY THE LOCATION OF THE
WATER RIGHT. IT IS NOT INTENDED
TO PROVIDE INFORMATION RELATIVE
TO THE LOCATION OF PROPERTY
OWNERSHIP.

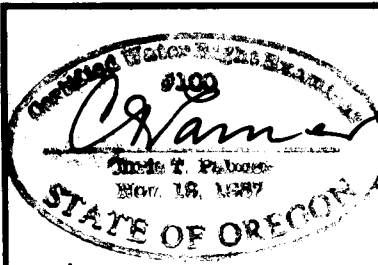

REVIEW 1-1-2007

FINAL PROOF SURVEY

UNDER
T-9300

IN THE NAME OF
BELL A GRAZING COOPERATIVE

Scale: 4 = 1 MILE

Date: NOV. 2006

Job: 2095-06

Dsn:

Drm: CHRIS

Ckd:



M.A. PALMER & SONS, INC.
ENGINEERING & SURVEYING
711 Ponderosa Village • Box 61
Burns, Oregon 97720

Sht. No.

of 1