


T.5S.&6S., R.4W., W.M.

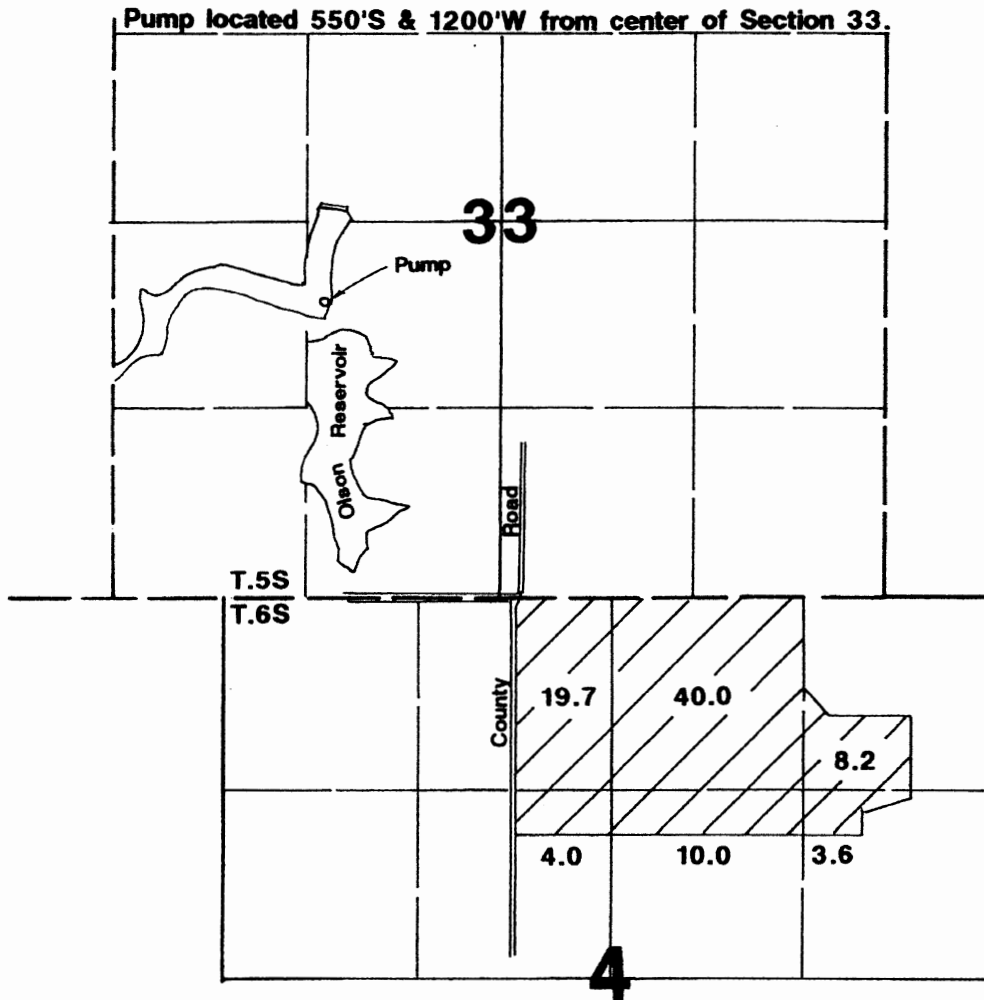


Final Proof Survey

Application #: 69657 Permit #: 50668

In Name Of

Aner Patty

Surveyed by J Grimm on August 24, 1993

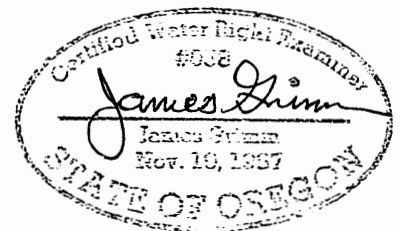

THIS MAP WAS PREPARED FOR THE PURPOSE OF IDENTIFYING THE LOCATION OF A WATER RIGHT ONLY AND IS NOT INTENDED TO PROVIDE LEGAL DIMENSIONS OR LOCATION OF PROPERTY OWNERSHIP LINES.