


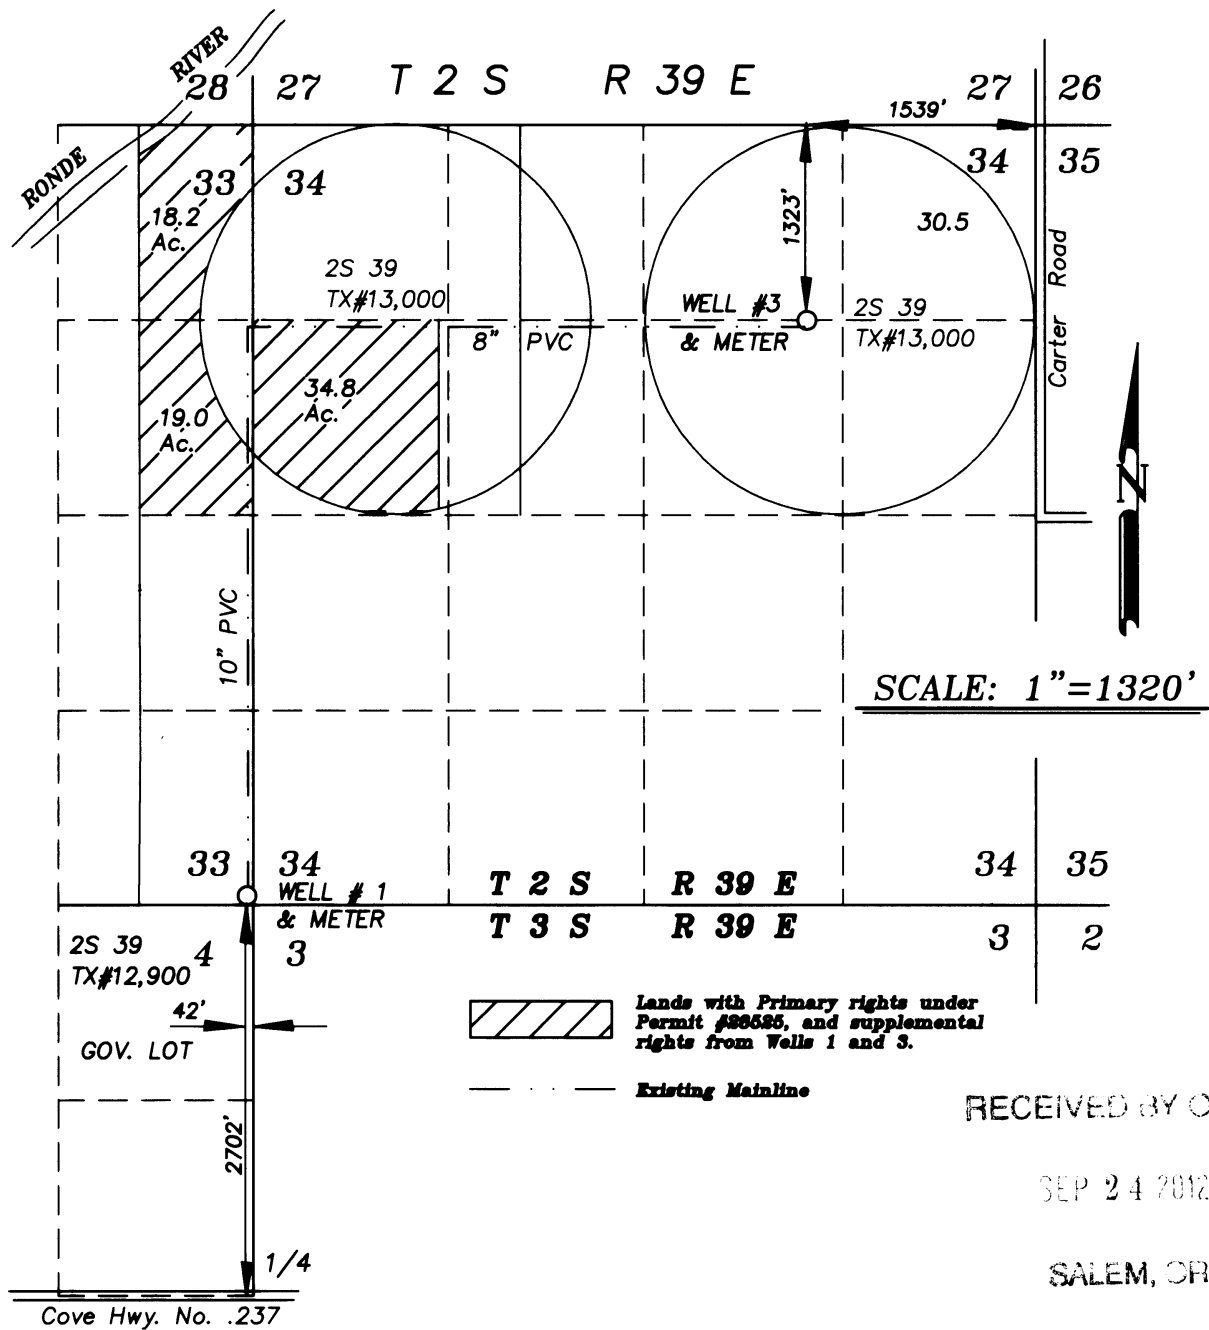

RECEIVED BY OWRD

SEP 24 2012

SALEM, OR

SEPTEMBER 7, 2010

FINAL PROOF MAP OF SUPPLEMENTAL WATER RIGHTS FROM WELLS #1 AND #3

FOR
BETTY J. GULZOW
By

Bagett-Griffith & Blackman
2006 Adams Ave.
La Grande Oregon 97850

Application No. G-16236
Permit Number G-15797



Note: The preparation of this map was for the purpose of identifying the location of the water rights and has no intent to provide dimensions or location of property ownership lines. Location information shown hereon was furnished by the applicant.