


SUPERSEDING

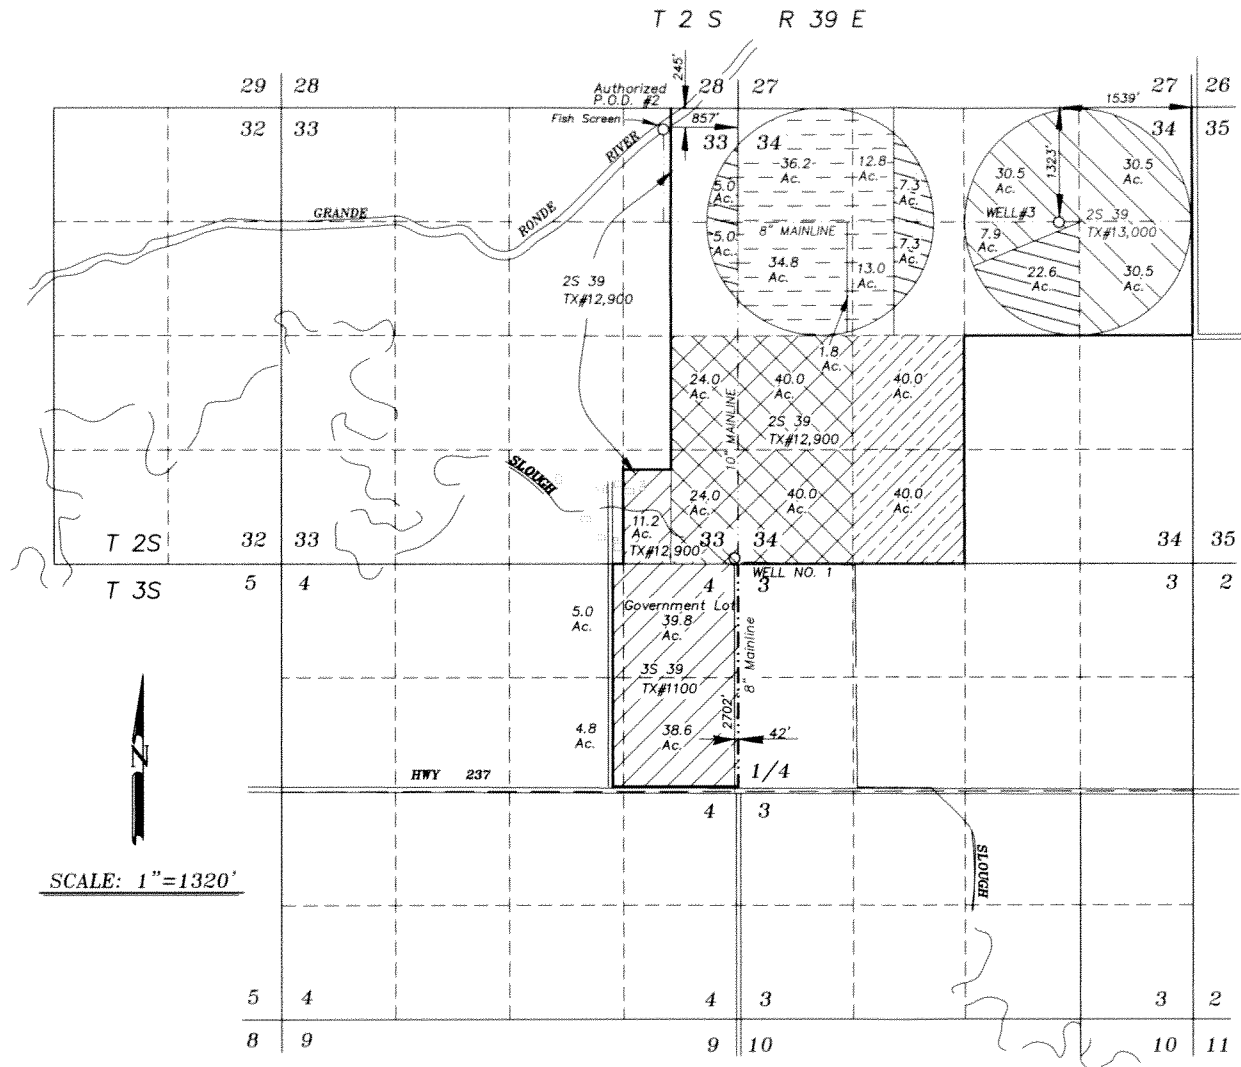

Lands that received Primary and Supplementary rights from Permit #G-5404. Wells 1, 3 and Point of Diversion.

Lands that received Primary rights from Permit #28706 and supplemental rights from Permit #2800. Wells 1, 3 and Point of Diversion.

Lands having supplementary water under Permit G-5404 remaining in place and to receive surface rights from Permit #27837. Wells 1, 3 and Point of Diversion.

[illegible]

Lands with water rights under Permit #28525. Wells 1, 3 and Point of Diversion.



Lands with Primary water rights under Permit #28706 and supplemental rights from Permit #2800. Wells 1, 3 and Point of Diversion.



Lands with Primary water rights under Permit #6860 and supplemental rights from Permit #2600. Wells 1, 3 and Point of Diversion.


Existing Mainline

Locations of Wells and P.O.D.s

Well number 1 (Gulzow well no. 1) is located 2702 feet North and 42 feet West from the East $\frac{1}{4}$ corner of Section 4.

Well number 3 (Guizow well) is located 1323 feet South and 1539 feet West from the Northeast corner of Section 34.

Authorized Point of diversion from the Grande Ronde River is located 245 feet South and 857 feet West from the Northeast corner of Section 33.

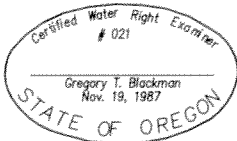

NOTE: The preparation of this map was for the purpose of identifying the location of the proposed water right and has no intent to provide dimensions or location of property ownership lines. Location information shown hereon was furnished by the applicant.

SUPERSEDING

FINAL REVISION
JULY 13, 2016

FINAL PROOF MAP FOR
CHANGE OF PLACE OF USE
POINT OF DIVERSION AND
ADDITIONAL POINT OF
APPROPRIATION
FOR

MIKE GULZOW

84

BAGETT - GRIFFITH & BLACKMAN
2006 ADAMS AVENUE
LAGRANDE, OREGON 97850

Application No. T-9123

Permit Number T-9123

SUPERSEDING