

BOOTH T 2 S R 30 E LANE

RECEIVED BY OWRD

MAR 14 2016

SALEM, OR

SCALE: 1"=1320'

WELL GPS POSITIONS


Well #1: Lat. 45° 21' 17.62576" N
Long. 117° 54' 22.87308" W

Well #2 (T-10838): Lat. 45° 21' 17.87192" N
Long. 117° 53' 52.21268" W

Well #3: Lat. 45° 21' 12.86204" N
Long. 117° 54' 41.69221" W

Well #4: Lat. 45° 21' 17.65154" N
Long. 117° 53' 25.14398" W

Well #1(T-10838): Lat. 45° 20' 52.30210" N
Long. 117° 54' 17.03346" W

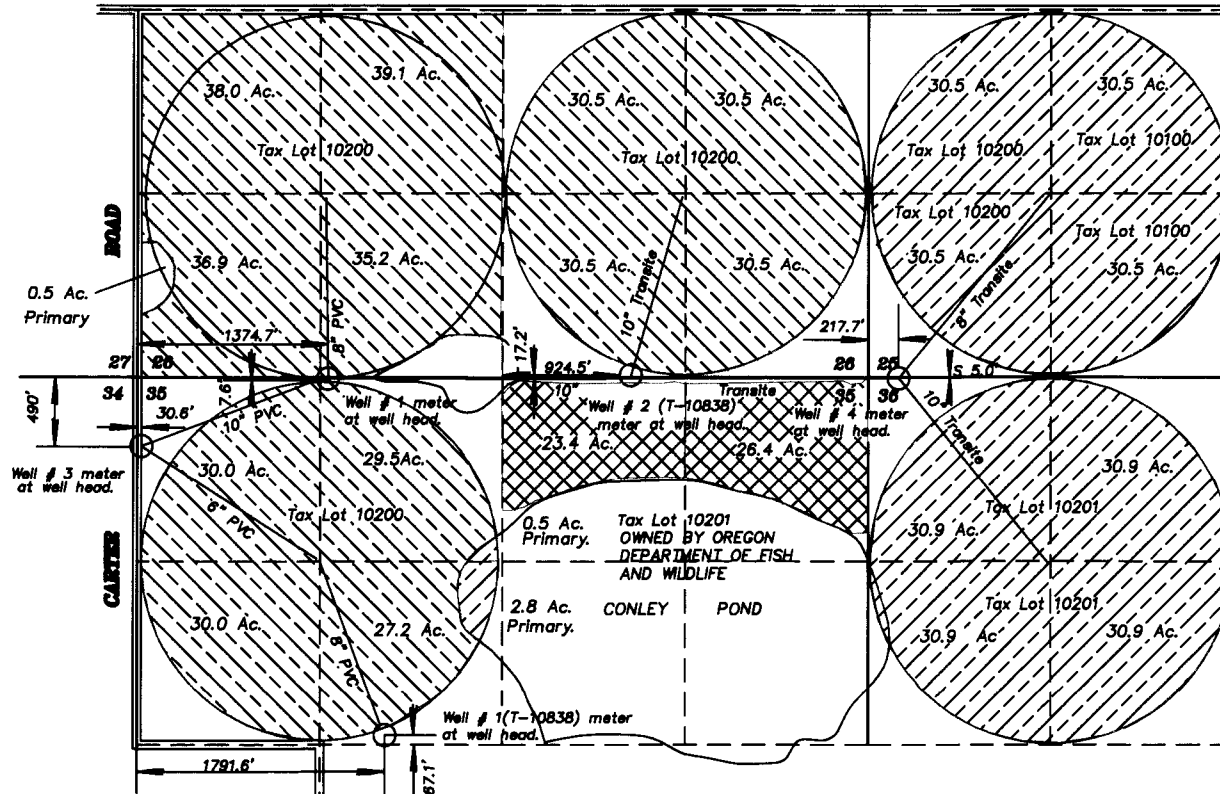

Primary 249.4 Acres

Supplemental 387.9 Acres

Lands under Permits G-5954 & G-6492 owned by ODF& W not watered with supplemental water

AUTHORIZED POINT OF APPROPRIATION

Well # 3, located S 490' and E 30.6 from NW cor Sec. 35

ADDITIONAL POINTS OF APPROPRIATION

Well # 1, located S 7.6' and E 1374.7' from NW cor Sec 35

Well # 2 (T-10838), located N 17.2' and E 924.5' from N 1/4 cor Sec 35

Well # 4, located S 5.0' and E 217.7' from NW cor Sec 36

Well # 1 (T-10838), located N 67.1' and 1791.6' E of W 1/4 cor of Sec 35.

June 4, 2014

CLAIM OF BENEFICIAL USE FOR APPROPRIATION OF WATERS UNDER PERMIT G-11074 AND FOR ADDITIONAL POINTS OF APPROPRIATION UNDER PERMIT AMENDMENTS T-10537 AND T-10838

BY

GREG BLACKMAN WATER RIGHTS
126 RIDGE DRIVE
LA GRANDE, OREGON 97850

APPLICATION NO. G-12055

PERMIT NUMBER G-11074, T-10537, T-10838



Renews: June 30, 2017

NOTE: The preparation of this map was for the purpose of identifying the location of the proposed water right and has no intent to provide dimensions or location of property ownership lines. Location information shown hereon was furnished by the applicant.