

*Supplemental Application 2000/01*

# WATER RIGHT TRANSFER APPLICATION MAP

## SHOWING A CHANGE IN POINT OF DIVERSION AND IN PLACE OF USE

### T.36 S. R.06 W. W.M.

**AFFECTING PORTIONS OF:**

**PERMIT No. 1290 CERT. No. 1953 &**

**PERMIT No. 9692 CERT. No. 8942**

**T - \_\_\_\_\_**  
**APPLICANT:**


**DUTCHER CREEK ENTERPRISES, INC.**  
**4611 UPPER RIVER ROAD**  
**GRANTS PASS, OREGON 97526**  
**Ph. (541) 474-2188**

THIS MAP IS FOR THE PURPOSE OF IDENTIFYING THE LOCATION OF THE WATER RIGHT ONLY, AND IS NOT INTENDED TO PROVIDE LEGAL DIMENSIONS OR LOCATIONS OF PROPERTY OWNERSHIP LINES.

**LEGEND:**

- AREA TO WHICH WATER RIGHTS ARE TO BE TRANSFERRED
- AREA FROM WHICH WATER RIGHTS ARE TO BE TRANSFERRED
- IRRIGATED UNDER PERMIT 1290 CERT. 1953
- IRRIGATED UNDER PERMIT 9692 CERT. 8942

MAP SHOWING POINTS OF DIVERSION  
**SCALE: 1" = 2640'**

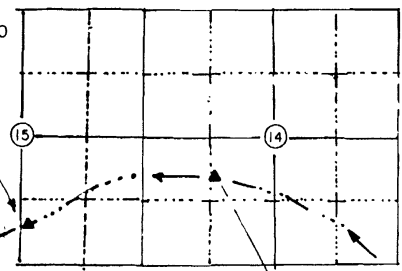

RECEIVED


JUL 28 2015

OWRD

S 61' E, 1580' FROM 1/4 CORNER SEC. 14 & 15

PROPOSED (HISTORIC) POINT OF DIVERSION  
 PERMIT 1290, CERT. 1953  
 CURRENT POINT OF DIVERSION  
 PERMIT 9692 CERT. 8942  
 FT. VANNOY IRRIGATION DISTRICT.

**PREPARED BY:**  
**JONATHAN C. SPERO C.W.R.E. 123**  
**1002 KINCAID RD./P.O. BOX 16**  
**WILLIAMS, OREGON 97544**  
**PH. (541) 846-6845**

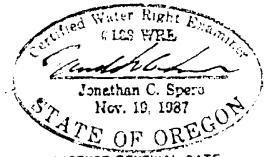

LICENSE RENEWAL DATE:  
 JUNE 30, 2002

REVISED: NOVEMBER 20, 2000

FEBRUARY 28, 2000

