


T9S, R5W, W.M. Section 2

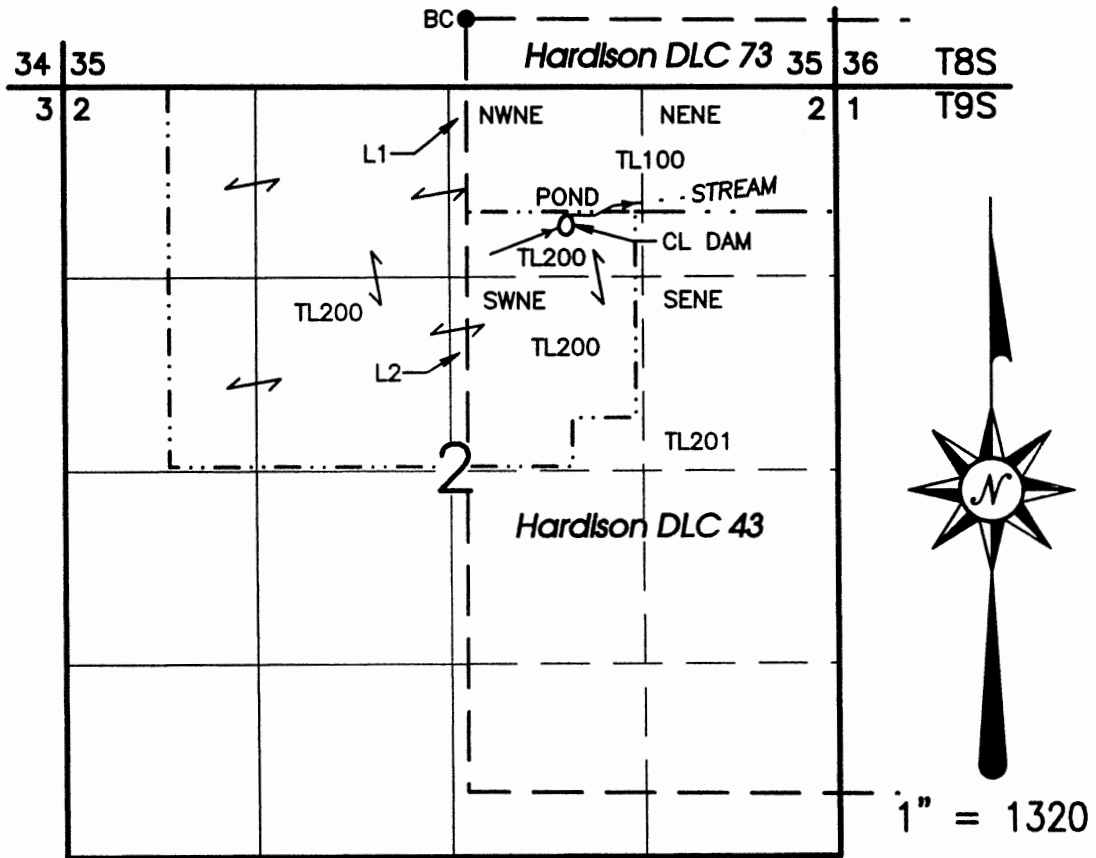

CENTER CREST OF DAM: 1410 FT SOUTH & 730 FT EAST OF THE
NW CORNER, GABRIEL HARDISON DLC 73, T8S, R5W, W.M.
POND: 1.2 AF
WATER USER MAP 9S 5W SEC 3, TL 200
INFORMATION FROM GPS SURVEY & POLK CO CS 12498

- POLK CO BRASS CAP
- - - - - TAX LOT BDRY
- — — — — DLC LINE
- ↔ COMMON OWNERSHIP

CLAIM OF BENEFICIAL USE MAP

FOR

LAMERS FORESTS LTD

Application R-81133


Permit R-11980

RECEIVED

MAY 28 2015

WATER RESOURCES DEPT
SALEM, OREGON

Prepared April 27, 2015
PARSONS SURVEYING
1915 S.E. Stone St
Corvallis, OR 97333.
541-752-7515
Project No. 1511

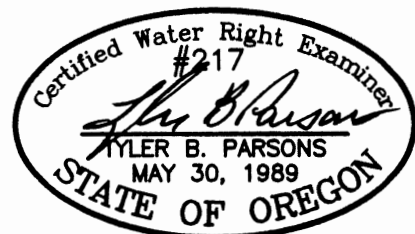

THIS MAP IS NOT INTENDED TO PROVIDE LEGAL DIMENSIONS
OR LOCATION OF PROPERTY OWNERSHIP LINES

RENEWS: 12/31/2016