


WATER RIGHT CLAIM OF BENEFICIAL USE MAP
 FOR
 SARAH HUCKA
 LOCATED IN THE
 SE 1/4 OF SW 1/4 SECTION 28,
 TOWNSHIP 19 SOUTH, RANGE 1 WEST, W.M.,
 TAX LOTS 2807, 2808,
 LANE COUNTY OREGON,
 APRIL 10, 2012
 APP # G-16155, PERMIT # G-16008
 TRANSFER # T-10893, VOL 81, PAGE 815
 CERTIFICATE #43337

RECEIVED BY OWR

NOV 15 2012


SALEM, OR

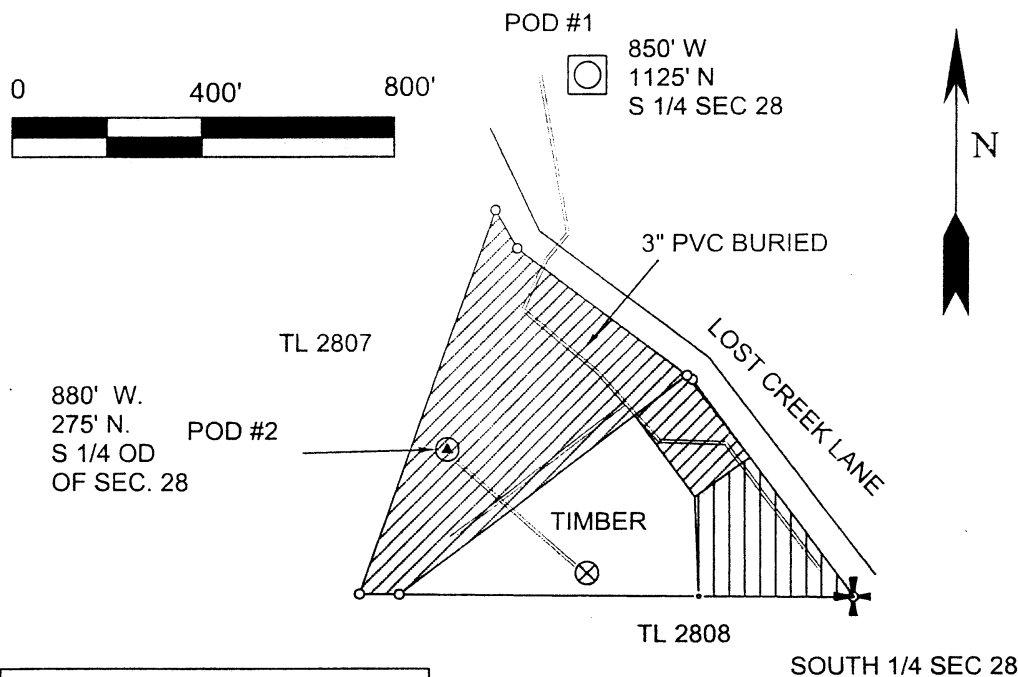

LEGEND	
	POD #1
	PROPERTY CORNER
	RESERVOIR BULGE
	WELL
	1/4 Corner
	Tick

- = IRRIGATION PERMIT
5.70 ACRES G-16008
- = TRANSFER T-10893 1.68 ACRES &
SUPPLEMENTAL 1.68 ACRES
IRRIGATION PERMIT G-16008

DISCLAIMER: THIS MAP IS NOT TO BE
 USED FOR PROPERTY LOCATION. IT
 IS FOR WATER RIGHT PURPOSES ONLY.

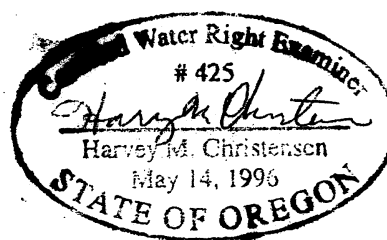

RECEIVED BY OWR

NOV 01 2012

SALEM, OR