


T. 4S., R. 12E., W. M.

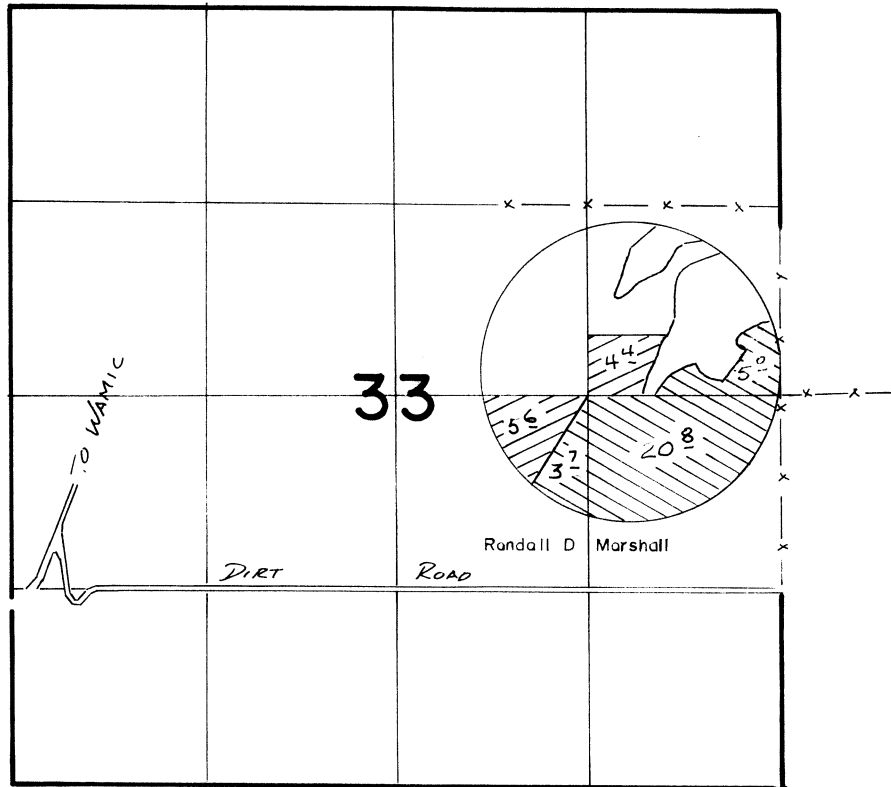

1911



1901

**FINAL PROOF SURVEY**

UNDER

**TRANSFER 4913**

IN NAME OF

Lost & Boulder Ditch Company.....

Surveyed 10-19..... 1988, by V.L. Church.....