


TOWNSHIP 8 SOUTH, RANGE 14 EAST, W.M.

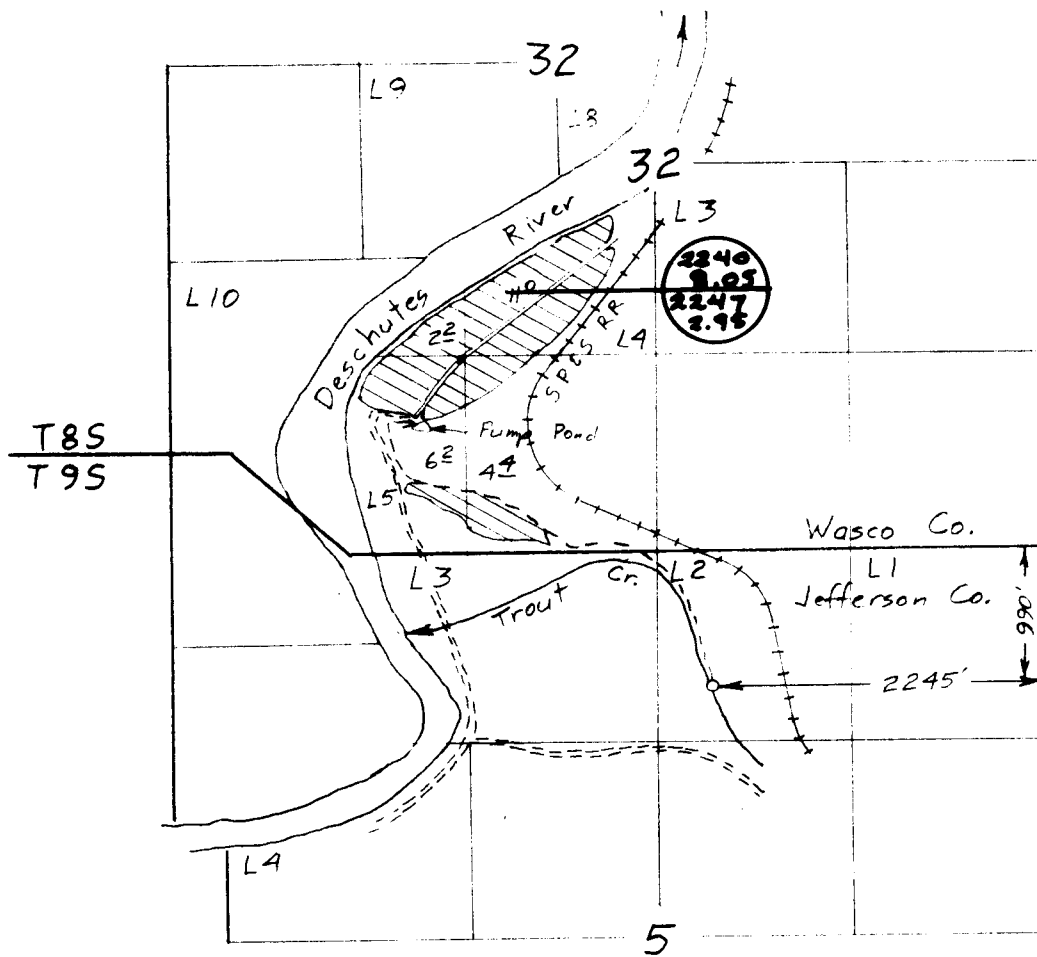


Scale 1" = 1320'

Surveyed Sep 28, 2001

Claim of Beneficial Use Map
for
KEN BUCK

T- 6866

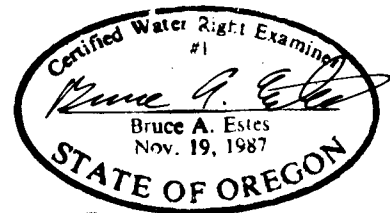

This map is for the purpose of
locating a water right only
and has no intent to provide
legal dimensions or the location
of property lines.

ESTES SURVEYS, LLC
 PO Box 17519 60382 Arnold Rd
 Salem, OR 97305-7519 Bend, OR 97702
 (503) 585-7593 (541) 382-7391

Map revised by WRD to reflect acreage by certificate. Mfb/wrd 4-25-16