



T.9S. R.2E. Section 19, W.M.

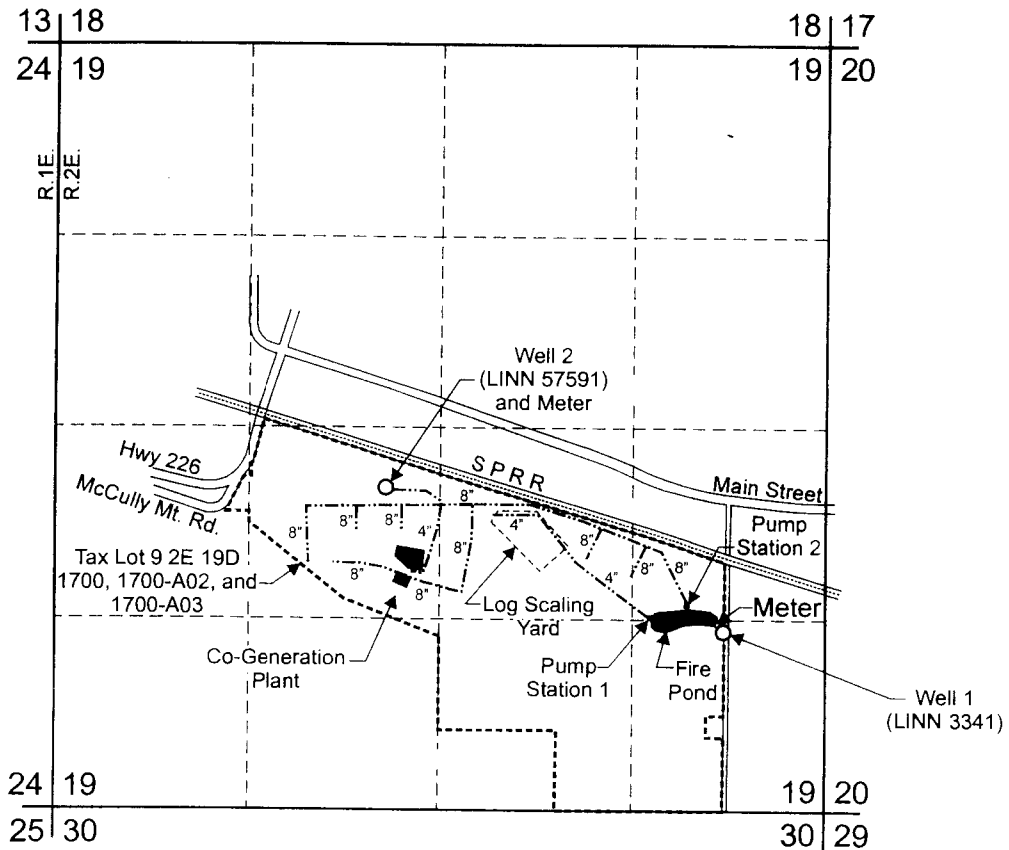


Well 1 (LINN 3341) is located 1,240 feet north and 690 feet west from the SE corner, Section 19.
 Well 2 (LINN 57591) is located 410 feet south and 370 feet west from the C 1/4 corner of Section 19.

- Tax lot boundary
- Water system mainline pipe

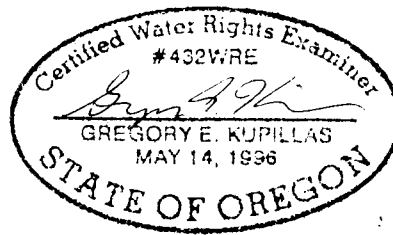

EXPIRATION DATE: 6/30/11

Scale: 1" = 1,320'

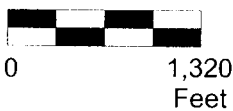

This map was prepared for the purpose of identifying the location of a water right only and is not intended to provide legal dimensions or location of property ownership lines.



Pacific Hydro-Geology Inc.

06/2010

Claim of Beneficial Use Map
 T-10119

Freres Lumber Company
 T.9S. R.2E. Section 19, W.M.