


CLAIM OF BENEFICIAL USE MAP
DENNIS & JUDY BOTTEM AND MARK & JENNIFER LYDON

TRANSFER #T-10693

A PORTION OF SECTION 8
TOWNSHIP 18 SOUTH, RANGE 5 WEST, W.M.
LANE COUNTY, OREGON

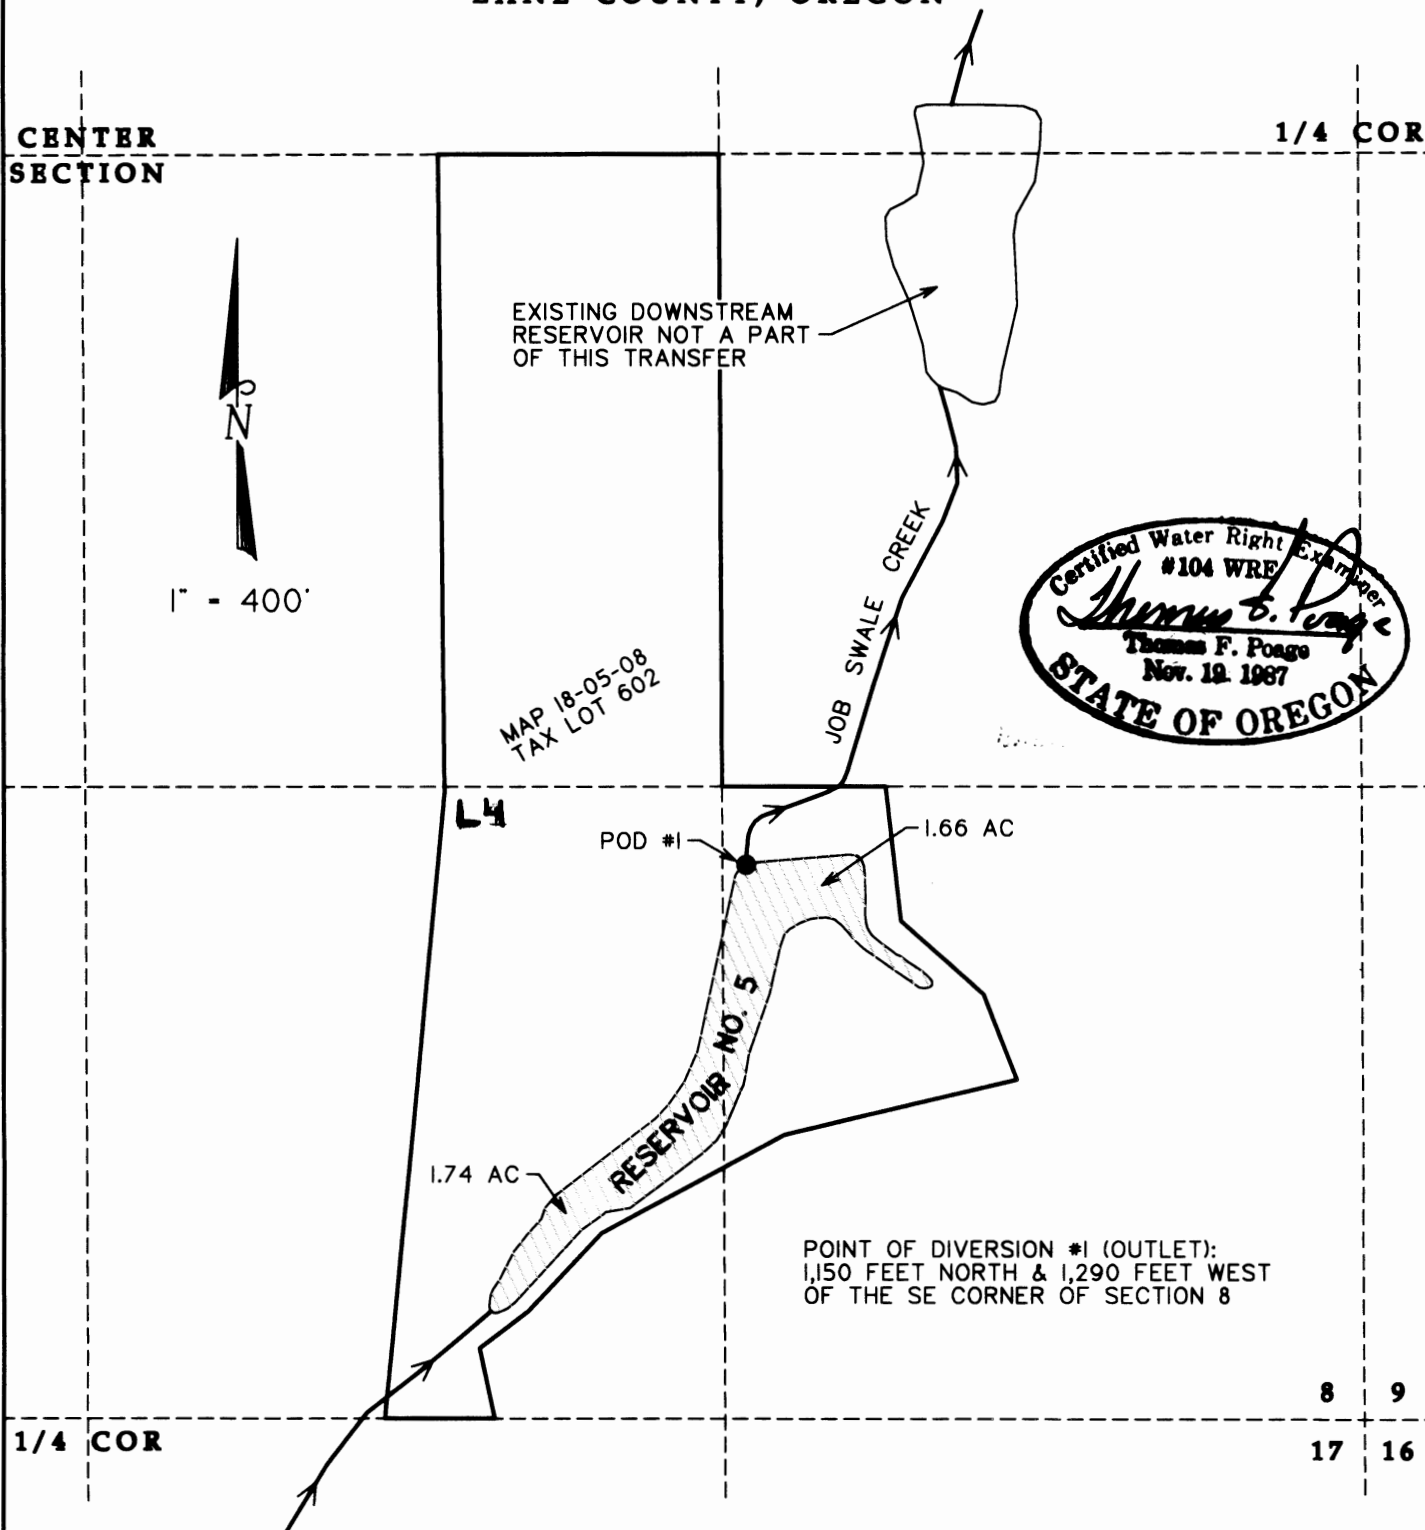

CADD FILE: 3973C0BU.GXD

DRAWN: 5/19/09 DPS

This map has been amended by OWRD to include gov't lot 4 in SWSE, Sec. 8. JWR/wed

8-3-16