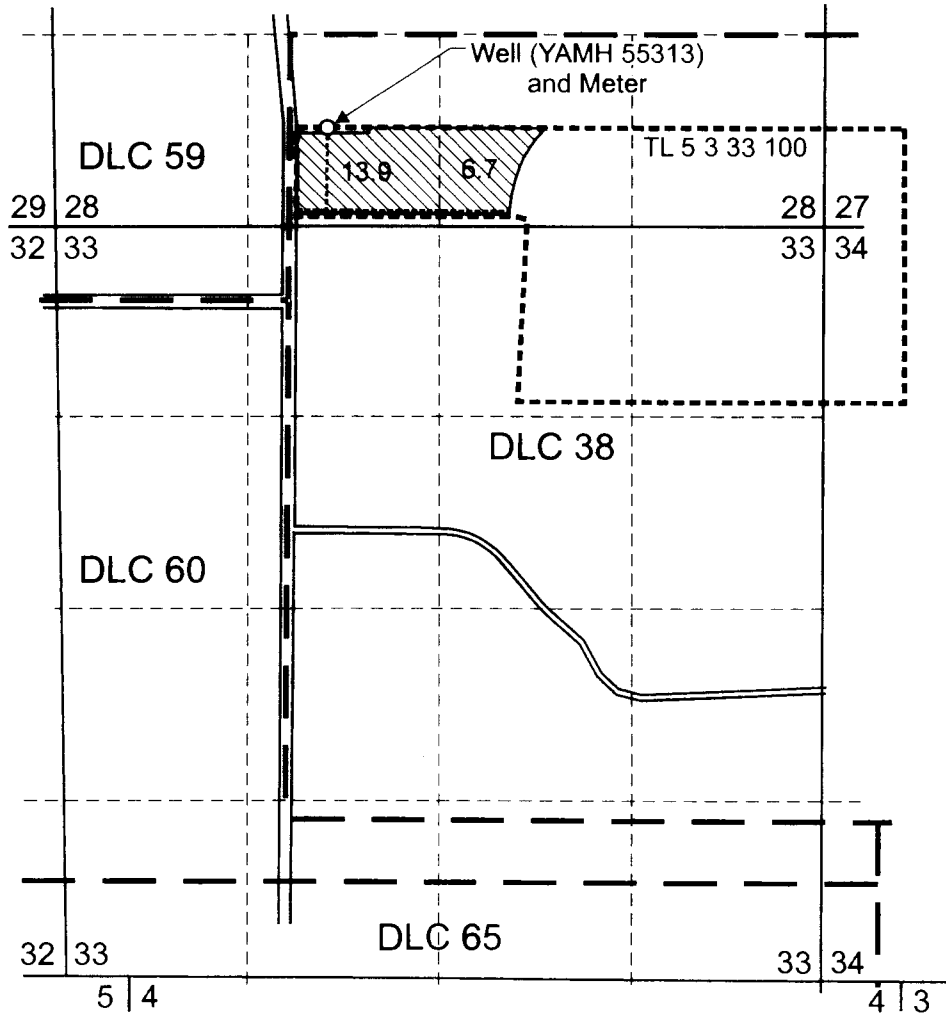
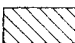

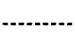
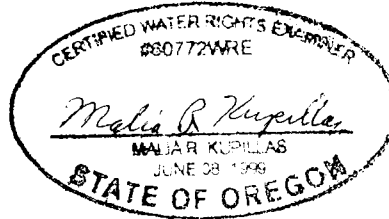


T.5S. R.3W. Section 28, W.M.



Well (YAMH 55313) is located 1,200 feet north and 265 feet east from the NE corner, Adam Matheny DLC 60.

-  Portion of Application G-12474, Permit G-12154 (20.6 Acres) irrigated using new point of appropriation.
-  Tax lot boundary
-  Mainline



EXPIRATION DATE 6/30/11

Scale: 1" = 1,320'



This map was prepared for the purpose of identifying the location of a water right only and is not intended to provide legal dimensions or location of property ownership lines.



Pacific Hydro-Geology Inc.

8/2011

Claim of Beneficial Use Map
Transfer T-9812

Carlton Nursery Co. LLC
T.5S. R.3W. Section 28, W.M.