
atto no 6-13837

WATER RESOUNCES DEPT. SALEM, OREGON

RECEIVED

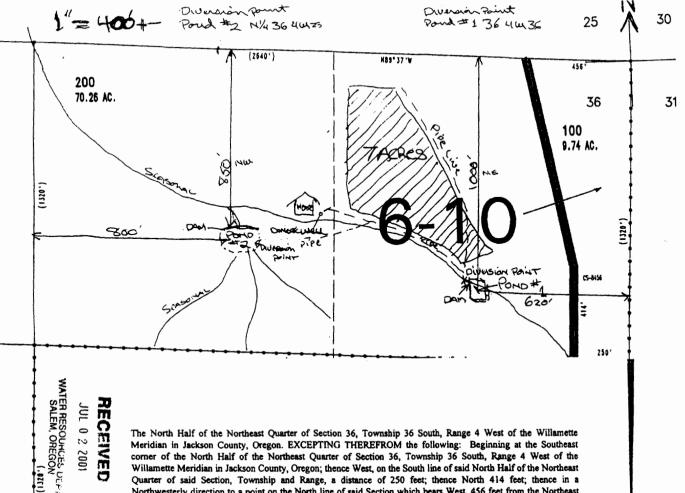

Northwesterly direction to a point on the North line of said Section which bears West, 456 feet from the Northeast corner of said Section; thence East, along the North line to said Northeast corner of said Section; thence South on the East line of said Section, to the point of beginning, TOGETHER WITH an easement for ingress and egress as described in instrument recorded as Document No. 77-18845, Official Records of Jackson County, Oregon.

-400'