


SW.1/4 OF THE SW.1/4, SECTION 11,
TWP. 1 SOUTH, RANGE 13 E. W.M.
WASCO COUNTY, OREGON

RECEIVED BY OWFD

JAN 20 2015

SALEM, OR

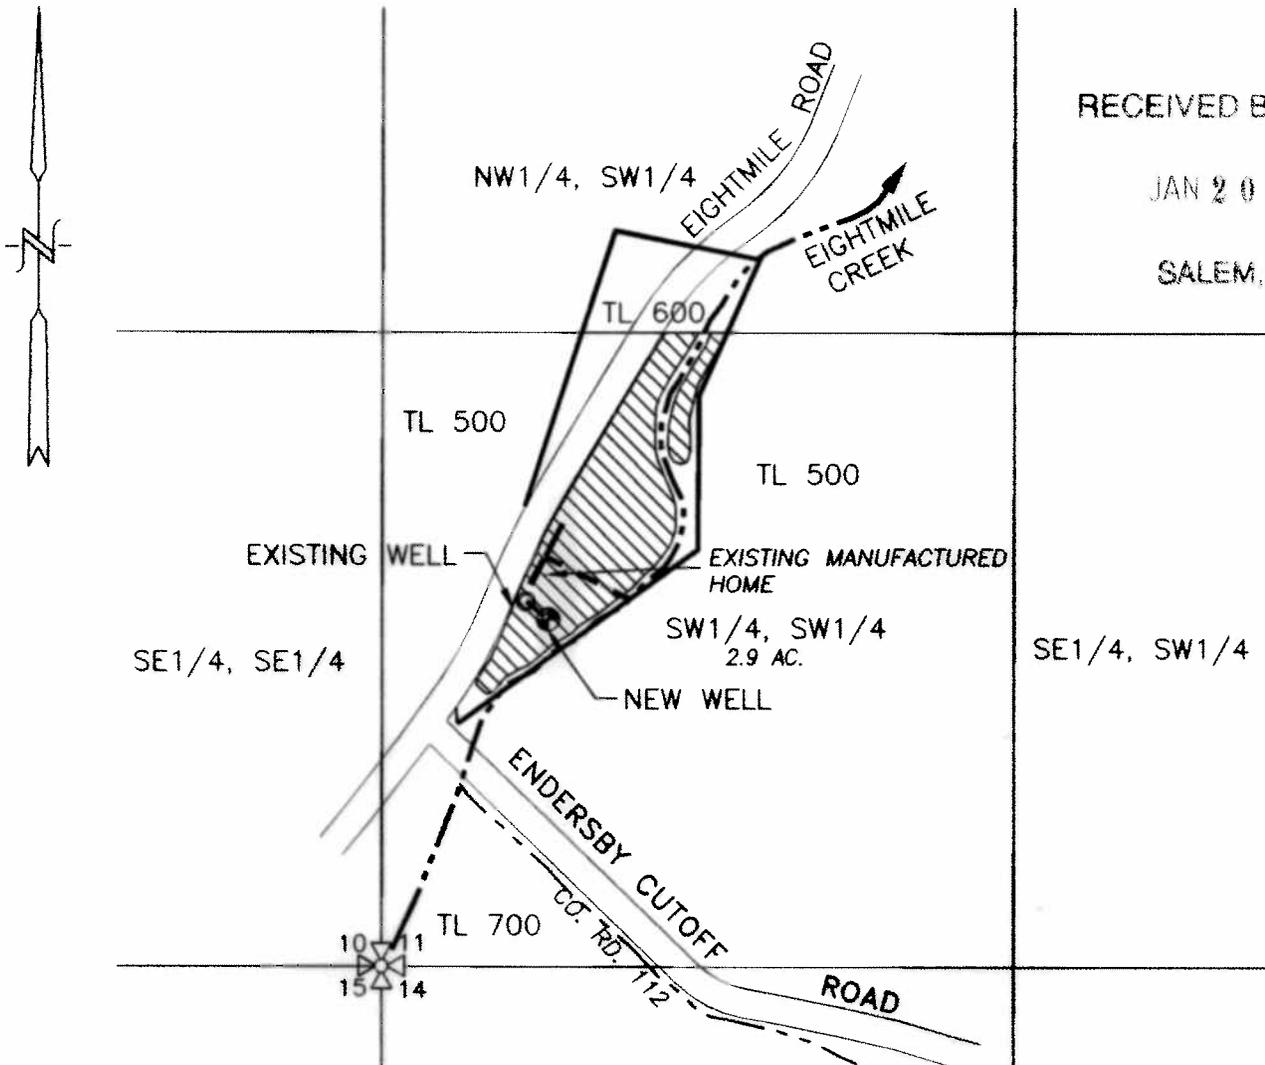

--- EXISTING IRRIGATION MAIN

⊙ EXISTING WELL, 760' N. & 300'(350' ON F.P. MAP) E. OF SW COR. SECTION 11

● NEW WELL, 723' N. & 347' E. OF THE SW CORNER SECTION 11

▨ APPLICATION AREA = 2.9 ACRES

NOTE: WHEN DRAFTING BY DEED, IT APPEARS THE FINAL PROOF SURVEY MAP WAS INCORRECTLY DRAW ABOUT 50 FEET EAST OF THE CORRECT LOCATION. MOVING FINAL PROOF SURVEY MAP 50 FEET WEST PUTS IT INSIDE DEED.

CLAIM OF BENEFICIAL USE MAP

SCALE: 1" = 400'


TRANSFER No. 10133

APPLICATION No. G-10452

PERMIT No. G-9527

IN THE NAME OF:
KENNETH L. FALK

DATE: JULY 23, 2008

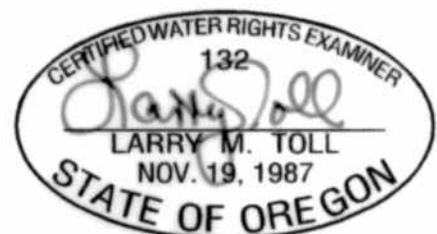

EXPIRES: 06/30/2010

TENNESON ENGINEERING Corp.
CONSULTING ENGINEERS
409 LINCOLN STREET
THE DALLES, OREGON 97058
541-296-9177 FAX 541-296-6657



NOTE:

"THIS MAP IS NOT INTENDED TO PROVIDE DIMENSIONS OR LOCATIONS OF PROPERTY OWNERSHIP LINES."

W.O. #11952wr