


SECTION

6

Per 5883
9176

TOWNSHIP 2N, RANGE 19E, W. M.

North

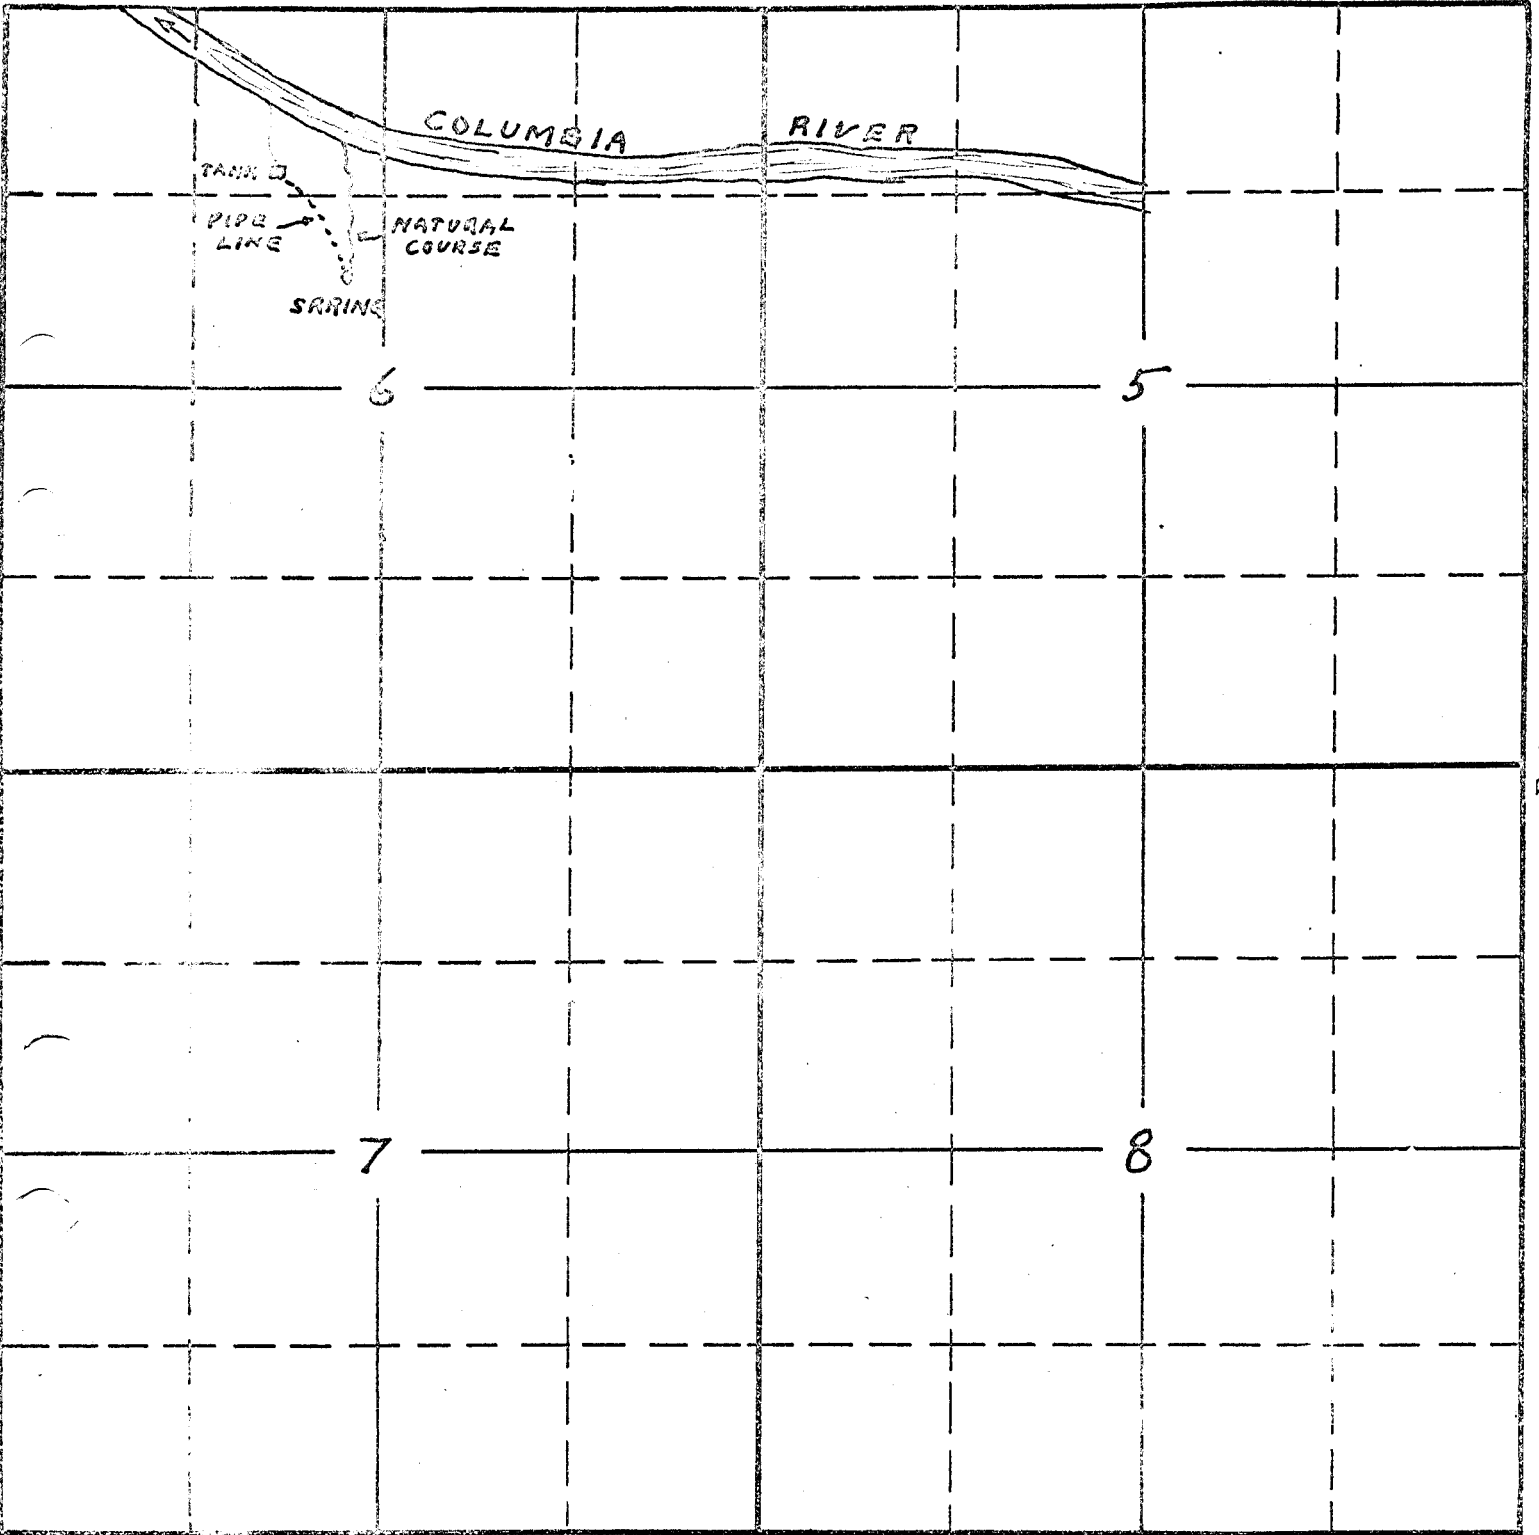

South

*Prepared in State Engineer's
office 6/15/31. B*

APPLICATION No. 8974
PERMIT No. 5883