


FD. 5/8" I.R.OO
PER CS 61-79

Oregon St. Park

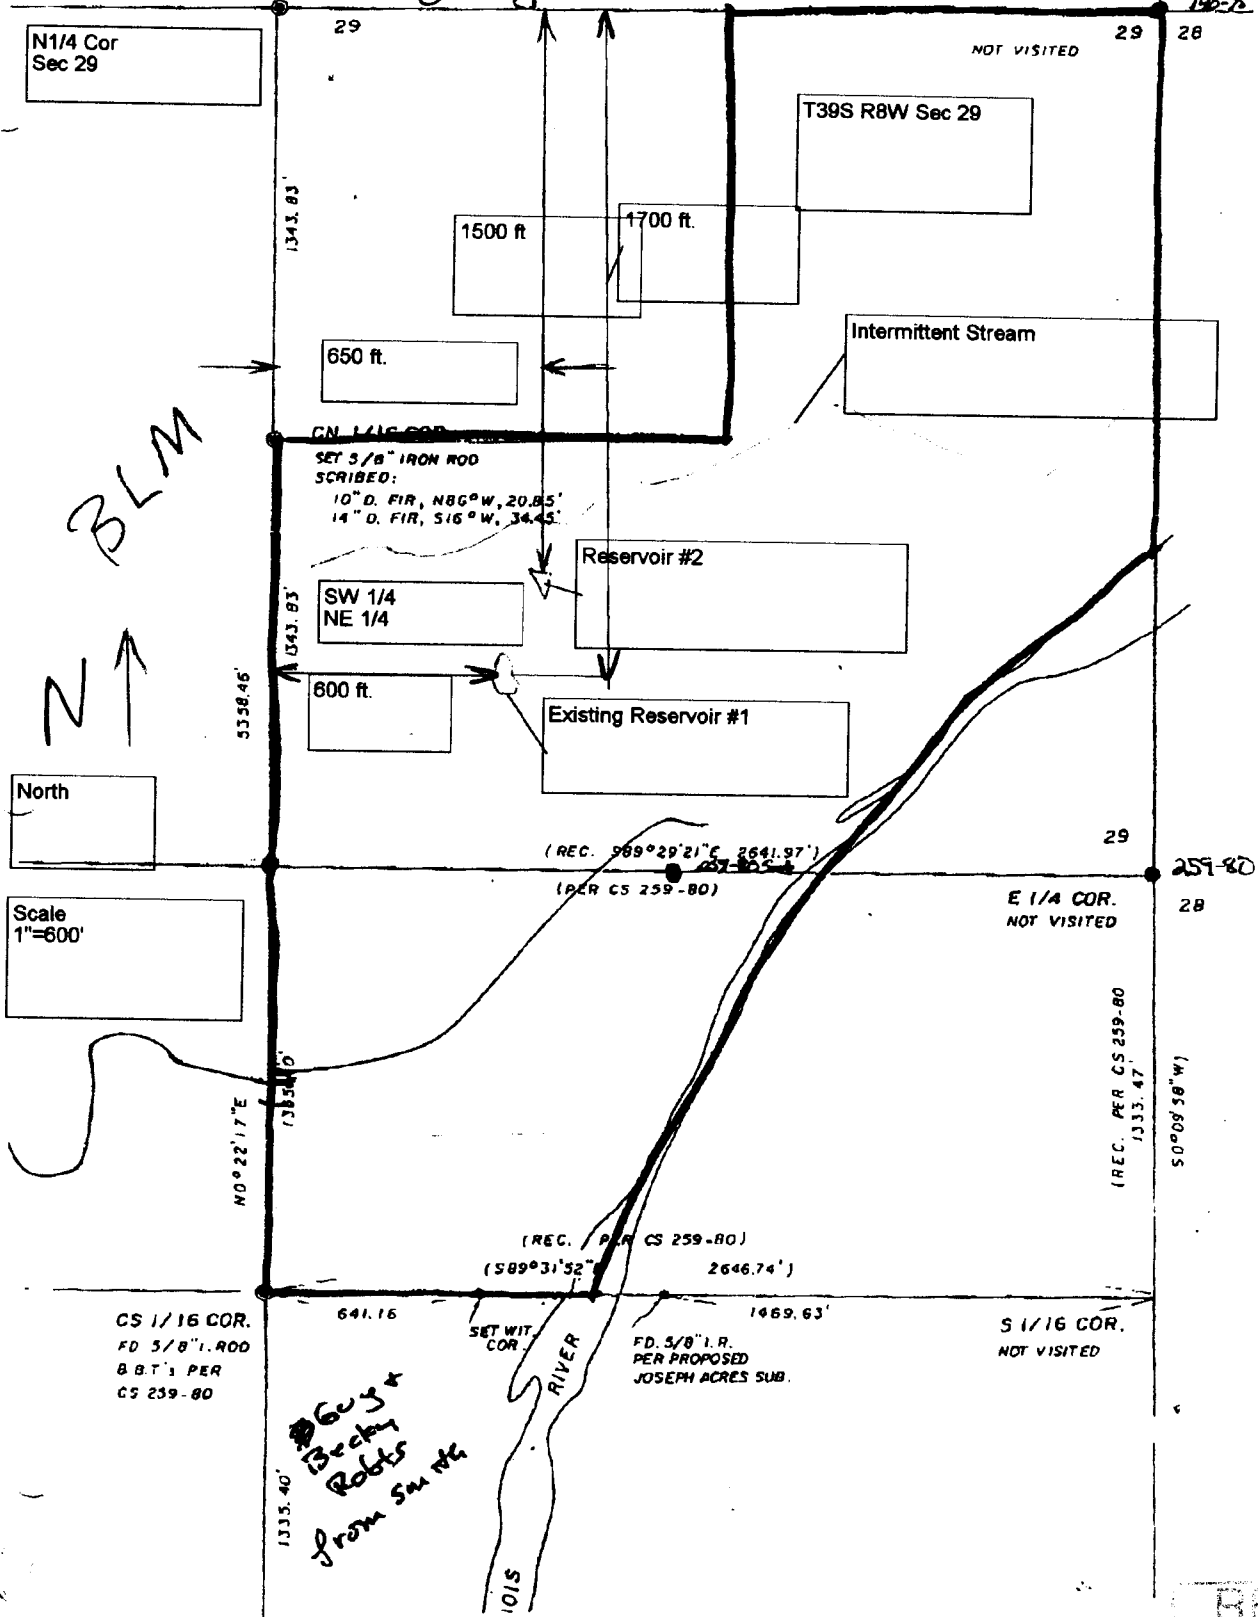

RECEIVED
JUN 20 2005
WATER RESOURCES DEPT
SALEM, OREGON

app no R-86345
Permit no R-14217

39 S - 8 W - 29