

CLAIM OF BENEFICIAL USE

TRANSFER T-7035

IN THE NAME OF MARTHA MILLER




TOWNSHIP 39 SOUTH, RANGE 7 WEST, W.M.

JOSEPHINE COUNTY, OREGON

RECEIVED

NOV 06 2009

WATER RESOURCES DEPT
SALEM, OREGON

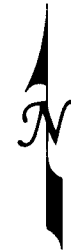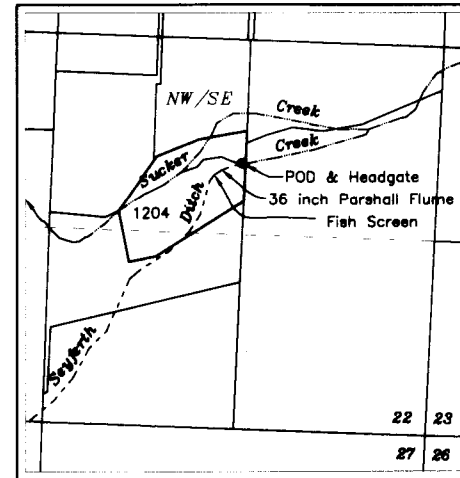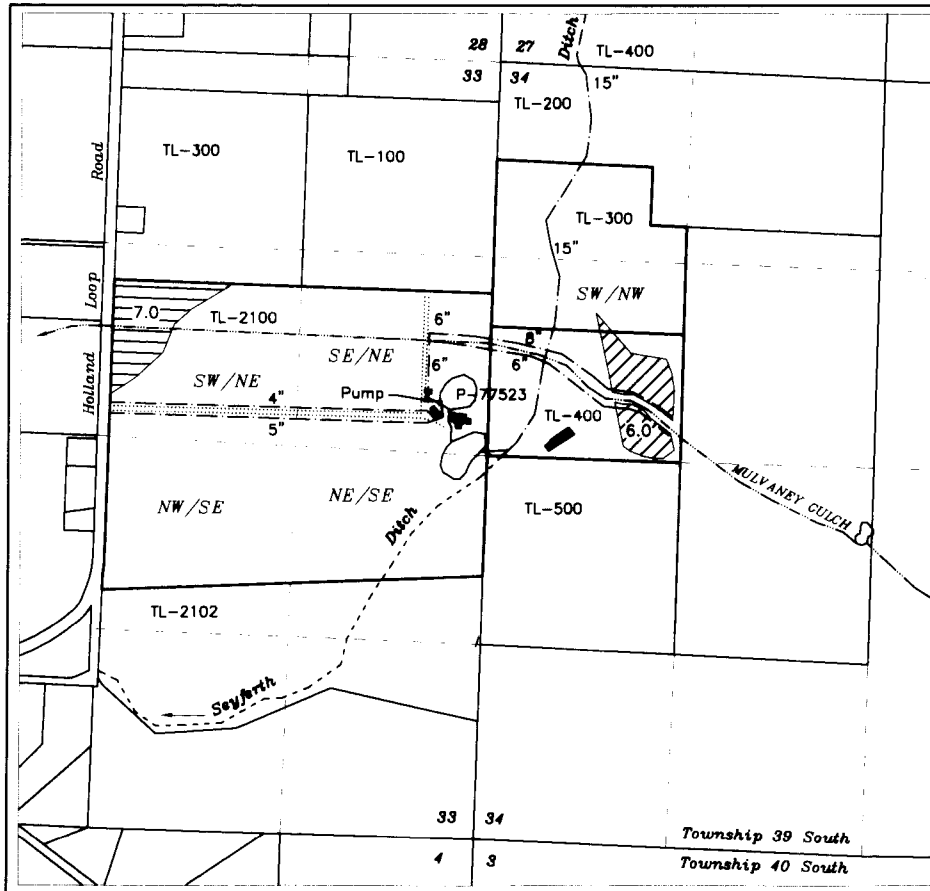



Scale

1 inch = 1320 feet

Point of diversion (POD) - 1820 feet north & 1330 feet west from the SE corner of section 22

Base map - Josephine County GIS tax lots overlaid on 2005 FSA aerial photo for assumed best fit

This map is not intended to provide legal dimensions or locations of property ownership lines

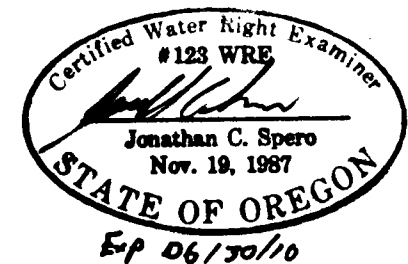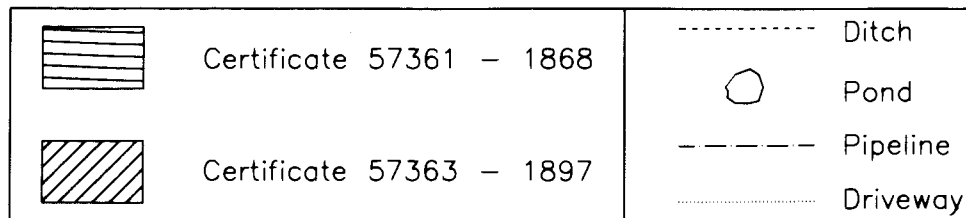

September 23, 2009 n.e.d.