


CLAIM OF BENEFICIAL USE MAP
 LOCATED IN THE NW¼NE¼, NE¼NE¼ & SW¼NE¼ OF
 SECTION 28, ALSO THE NW¼ OF SECTION 27, TOWNSHIP 29 SOUTH,
 RANGE 14 WEST, WILLAMETTE MERIDIAN
 APPLICATION S-73462 & PERMIT 52613
 APPLICATION R-73461 & PERMIT R-11924

PREPARED FOR: DAVID S. PECK
 PREPARED BY: DENNIS GOUDE
 DATE PREPARED: AUGUST 10, 2010

Scale 1"=1320'

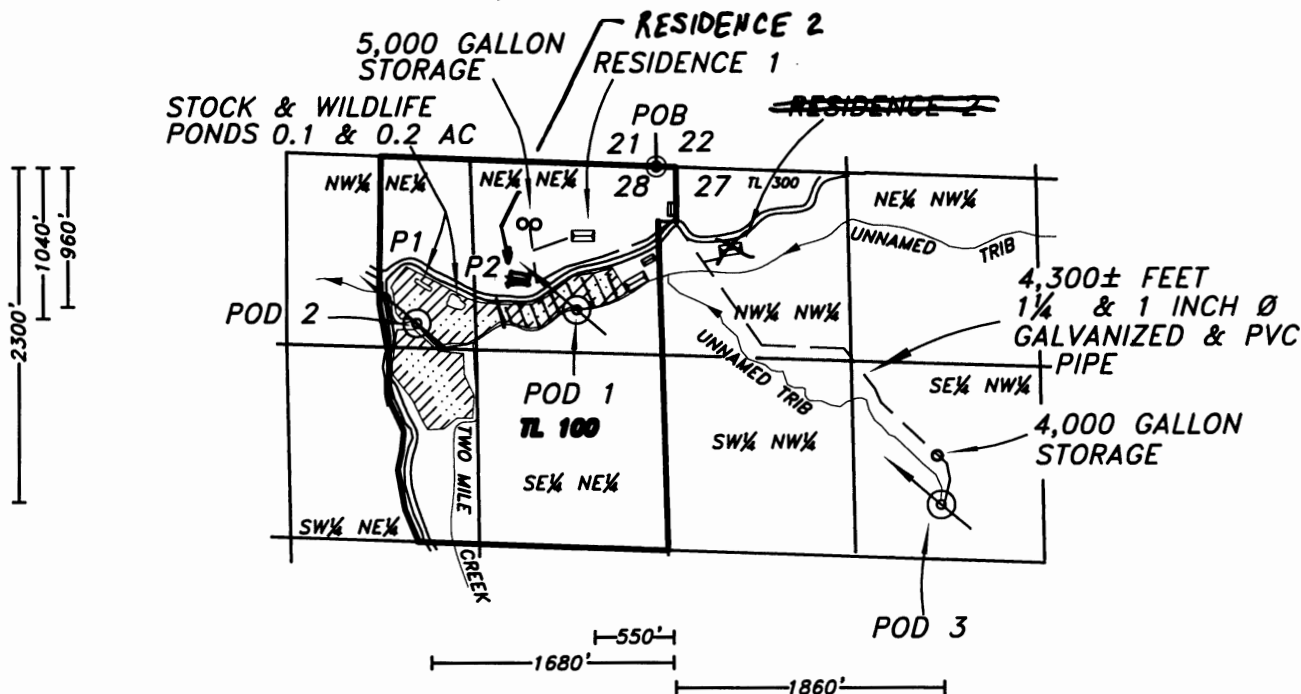

NOTE:

IRRIGATED ACREAGE

NW¼ NE¼ 3.0 ACRES CR
 NE¼ NE¼ 3.2 ACRES, being 2.5 for IR, and 0.7 for CR
 SW¼ NE¼ 5.0 ACRES CR

NOTE:

ALL POINTS OF DIVERSION AND PONDS ARE LOCATED FROM THE NORTHEAST CORNER OF SECTION 28, TOWNSHIP 29 SOUTH, RANGE 14 WEST W.M.

P.O.D. 1 550 FEET WEST & 960 FEET SOUTH.
 P.O.D. 2 1680 FEET WEST & 1040 FEET SOUTH
 P.O.D. 3 1860 FEET EAST & 2300 FEET SOUTH.
 POND 1 1617 FEET WEST & 810 FEET SOUTH.
 POND 2 1390 FEET WEST & 930 FEET SOUTH.

NOTE:

POINTS OF DIVERSION 1 & 2 ARE SEASONAL PORTABLE PUMP. POINT OF DIVERSION 3 IS A INSPRING DEVICE. SEE ATTACHED PHOTO. ALL POINTS OF DIVERSION WERE TIED AT TIME OF APPLICATION BY CWRE #054

LEGEND


POB
 (POINT OF BEGINNING)

POD
 (POINT OF DIVERSION)

RESIDENCE & OUT BUILDINGS
 (NOT TO SCALE)

IRRIGATED AREA

IR= Irrigation
 CR= Cranberry Operations

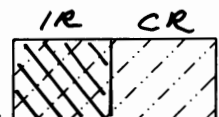

EXPIRES 12/31/2011

EXAMINERS DISCLAIMER STATEMENT

The preparation of this map was for the purpose of identifying the location of the Water Right only and has no intent to provide dimensions or location of property ownership lines.

Stuntzner Engineering
 & Forestry, L.L.C.

ENGINEERING • LAND SURVEYING • FORESTRY
 PLANNING • WATER RIGHTS

705 South 4th St.
 Post Office Box 118
 Coos Bay, Oregon 97420

Phone: (541) 267-2872
 Fax: (541) 267-0588

Map revised by WRD 10-23-15 mfb to 8/8/2016 Residence #2 added