


FINAL PROOF SURVEY MAP IN THE NAME OF
THOMAS H. DeARMOND

T-10532

T 4 S, R 1 W, W.M. Section 30,31,32

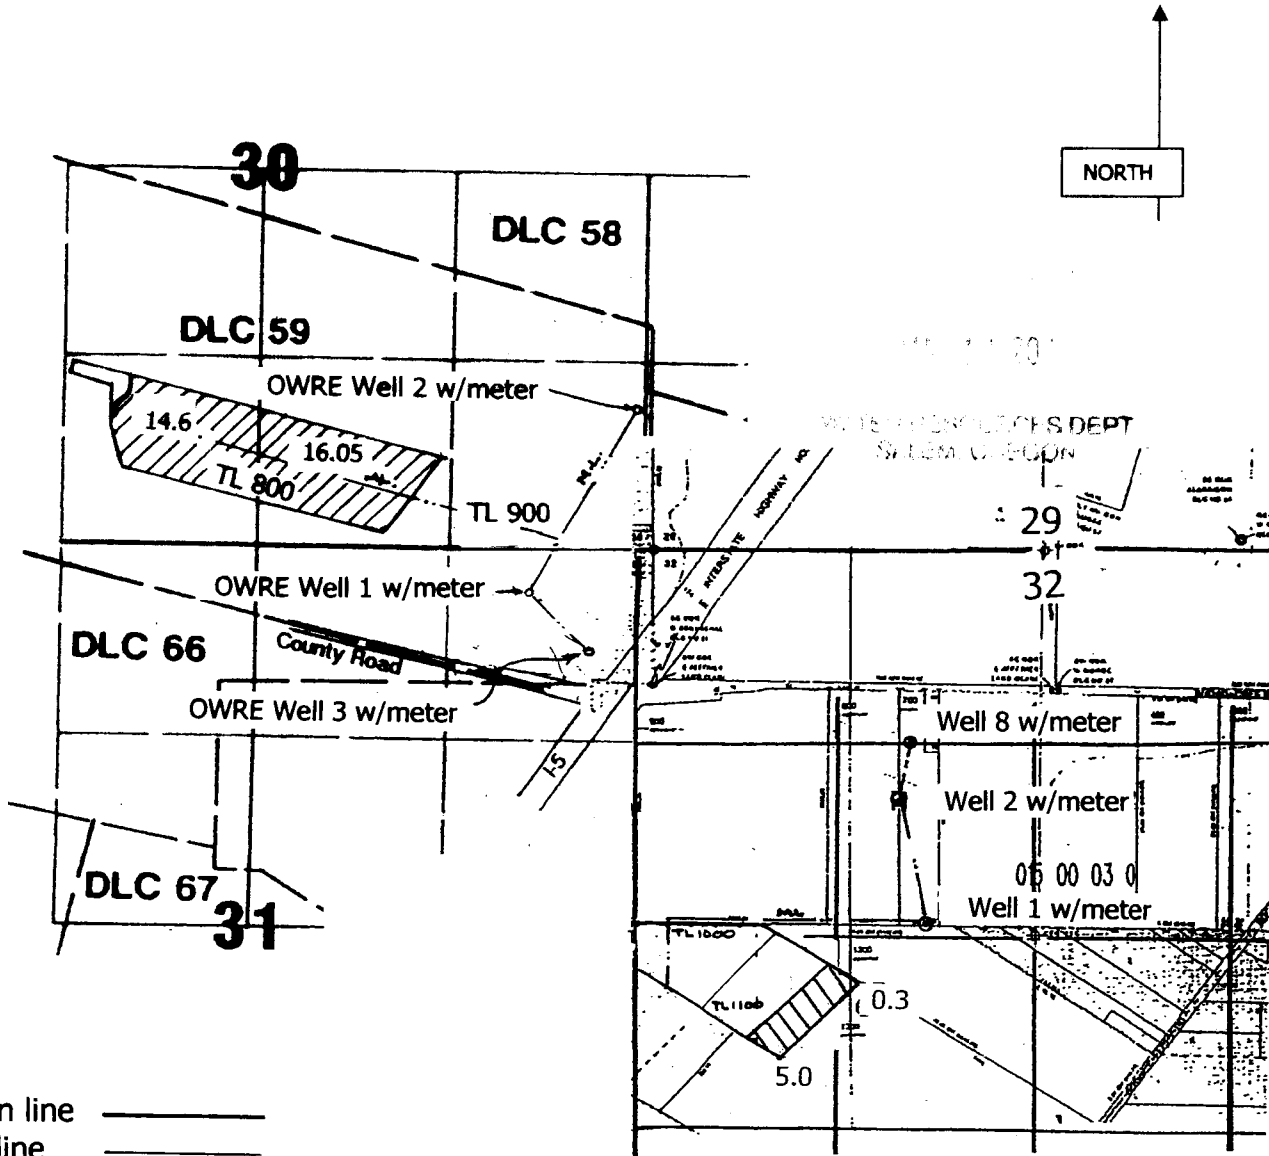


- Section line _____
- 1/4 1/4 line _____
- DLC line _____
- Pipe line _____
- Tax Lot line _____

OWRE WELL 1: 607' N & 812' W, **OWRE WELL 3:** 220' N & 400' W both from the SE cor DLC 59, **OWRE WELL 2:** 1000' N & 50' W from the SE cor sec 30. **WELL 1:** 60' N & 1950' E, **WELL 2:** 980' N & 1650' E both from the W 1/4 cor sec 32, **WELL 8:** 1380' N & 920' W from the center sec 32.

Scale 1" = 1320'

This map is not intended to provide dimensions or locations of property ownership lines.

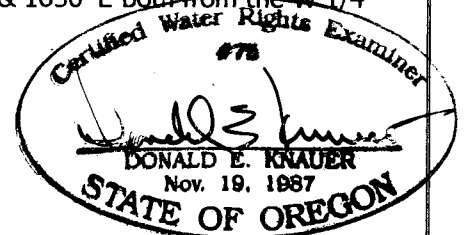

RENEWAL DATE: 6/30/2015