

Earl J Dixie Hathrop POB 279 Canyon City, OR 97820

Mrs. James Hayes P.O. Box 989 Mt. Vernon Oregon 97865 P-45912
~~Mr. Joseph Schmitz P.O. Box 326 Mt. Vernon Oregon 97865 R-8291~~

long.
119° 03' 35"


↑
N

Exhibit A

sec 24

R 30E T 14S

long.
119° 03' 36"

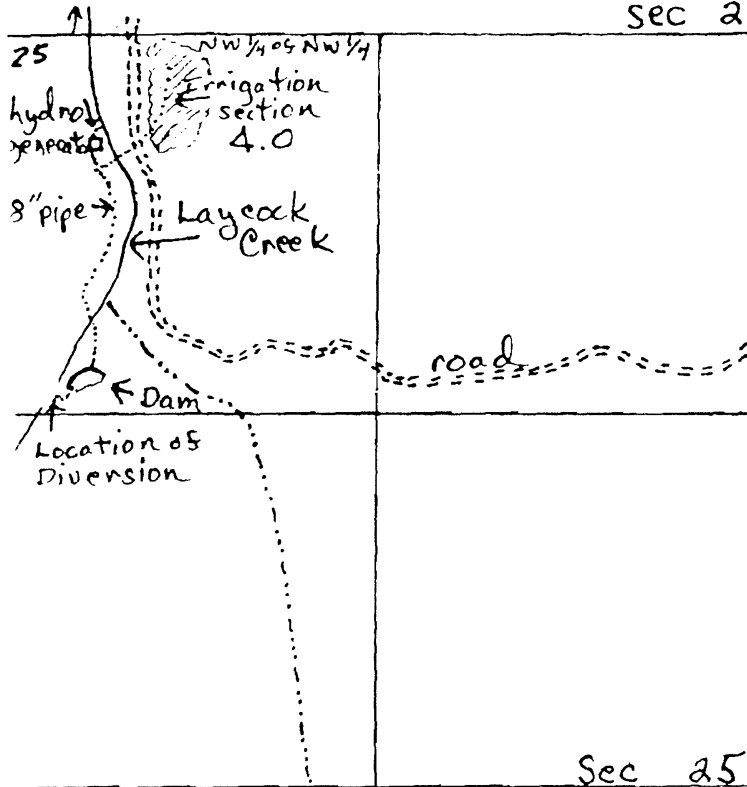

Application No. R-6195 & 6196
Permit No. R 8291
45912

The reservoir is in the
NW 1/4 NW 1/4 Sec 25, T. 14 S.,
R. 30 E., W.M. Tax Lot 3014.

Sec 25

lat. 44° 20' 10"

point of Diversion
1400 ft S - 160 ft E NW Corner
Sec 25

place of Dam
1200 ft. S - 200 ft E NW Corner
Sec 25

point of water re-entry
to Laycock Creek
500 ft. S - 400 ft E NW
Corner Sec 25

RECEIVED

OCT 18 2000

WATER RESOURCES DEPT
SALEM, OREGON

Sec 36

RECEIVED BY OWRD

MAY 26 2015

8" To 1 mile SALEM, OR