

Scale 1" = 800 ft  
Township 10S

N ↑

Range 4W  
Section 15

quarter/quarters 10 41

SW

tax lot 140  
700


RECEIVED

JUL 17 2001

WATER RESOURCES DEPT.  
SALEM, OREGON

Beginning of Pond II  
is located 1300' E  
and 1800' N  
Section Corner

8-05

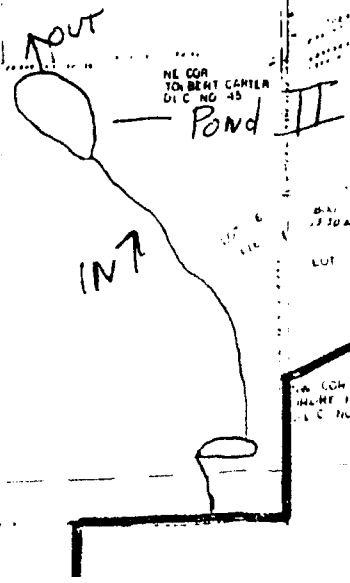

16, 15  
21, 22

Permit No. 284806

JUN 03 2015

RECEIVED BY OWRD

SALEM, OR

16 15  
21 22

